


1	LOCATION OF WATER WELL:	Fraction	Section Number	Township Number	Range Number
	County: <u>Washington</u>	1/4 1/4 1/4	<u>1</u>	<u>2</u>	<u>1E</u>

Distance and direction from nearest town or city street address of well if located within city?  
2 miles east and 4 miles north of Haddam

2 WATER WELL OWNER: Phyllis Milligan  
 RR#, St. Address, Box #: 1201 5th St Board of Agriculture, Division of Water Resources  
 City, State, ZIP Code : Fairbury, NE 68352 Application Number:

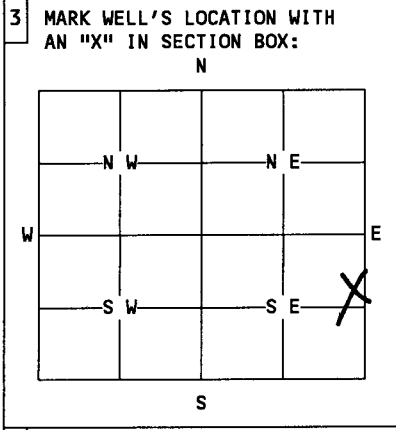

4 DEPTH OF WELL.....123.....ft.  
 WELL'S STATIC WATER LEVEL. No. H<sub>2</sub>O.ft.  
 WELL WAS USED AS:  
 1 Domestic      5 Public Water Supply      9 Dewatering  
 2 Irrigation      6 Oil Field Water Supply      10 Monitoring Well  
 3 Feedlot      7 Lawn and Garden Only      11 Injection Well  
 4 Industrial      8 Air Conditioning      12 Other.....  
 Was a chemical/bacteriological sample submitted to Department? Yes....No.   
 If yes, mo/day/yr sample was submitted.....  
 Water Well Disinfected: Yes.  No.....

5 TYPE OF BLANK CASING USED:  
 1 Steel      3 RMP (SR)      5 Wrought      7 Fiberglass      9 Other (specify below)  
 2 PVC      4 ABS      6 Asbestos-Cement      8 Concrete Tile  
 Blank casing diameter.....4.....in.      Was casing pulled? Yes.  No..... If yes, how much.....6'  
 Casing height above or below land surface.....72.....in.

6 GROUT PLUG MATERIAL: 1 Neat cement      2 Cement grout       3 Bentonite      4 Other.....  
 Grout Plug Intervals: From.....ft. to.....ft., From.....ft. to.....ft., From..... to.....ft.  
 What is the nearest source of possible contamination:  
 1 Septic tank       6 Seepage pit       11 Fuel storage       16 Other (specify below) yard  
 2 Sewer lines       7 Pit privy       12 Fertilizer storage  
 3 Watertight sewer lines       8 Sewage lagoon       13 Insecticide storage  
 4 Lateral lines       9 Feedyard       14 Abandoned water well  
 5 Cess Pool       10 Livestock pens       15 Oil well/Gas well  
 Direction from well? all sides.      How many feet? immediately.

FROM	TO	PLUGGING MATERIALS
<u>0</u>	<u>4.5</u>	<u>Topsoil</u>
<u>4.5</u>	<u>5.0</u>	<u>Bentonite Plug</u>
<u>5.0</u>	<u>123</u>	<u>Clay Soil</u>

No Chlorine or Sand was needed since no water was in the well.

7 CONTRACTOR'S OR LANDOWNER'S CERTIFICATION: This water well was plugged under my jurisdiction and was completed on (mo/day/year).....3-15-03..... and this record is true to the best of my knowledge and belief. Kansas Water Well Contractor's License No. .... This Water Well Record was completed on (mo/day/year) 5-20-03..... under the business name of Rocky B. Norman by (signature) Rocky B. Norman

INSTRUCTIONS: Use typewriter or ball point pen. Please press firmly and print clearly. Please fill in blanks, underline or circle the correct answers. Send top three copies to Kansas Department of Health and Environment, Bureau of Water, Topeka, Kansas 66620-0001. Telephone: 913/296-3565. Send one to Water Well Owner and retain one for your records.