


WATER WELL RECORD Form WWC-5 KSA 82a-1212

1 LOCATION OF WATER WELL: County: Washington Fraction: NE 1/4 NE 1/4 NE 1/4 Section Number: 28 Township Number: T 2 S Range Number: R 1 E/W

Distance and direction from nearest town or city street address of well if located within city?
Haddam, Ks

2 WATER WELL OWNER: KDHE
RR#, St. Address, Box #: Forbes Field, Bldg 740 Board of Agriculture, Division of Water Resources
City, State, ZIP Code: Topeka, Ks 66620 Application Number: MW 25

3 LOCATE WELL'S LOCATION WITH AN "X" IN SECTION BOX: 4 DEPTH OF COMPLETED WELL: 40 ft. ELEVATION: 1423.02

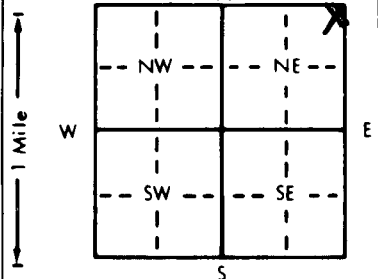

Depth(s) Groundwater Encountered: 1. 21.75 ft. 2. 40 ft. 3. 40 ft.
WELL'S STATIC WATER LEVEL: 21.75 ft. below land surface measured on mo/day/yr
Pump test data: Well water was _____ ft. after _____ hours pumping _____ gpm
Est. Yield _____ gpm: Well water was _____ ft. after _____ hours pumping _____ gpm
Bore Hole Diameter: 8 in. to 40 in. and _____ in. to _____ in.
WELL WATER TO BE USED AS: 5 Public water supply 8 Air conditioning 11 Injection well
1 Domestic 3 Feedlot 6 Oil field water supply 9 Dewatering 12 Other (Specify below)
2 Irrigation 4 Industrial 7 Lawn and garden only 10 Monitoring well
Was a chemical/bacteriological sample submitted to Department? Yes _____ No X If yes, mo/day/yr sample was submitted _____
Water Well Disinfected? Yes _____ No X

5 TYPE OF BLANK CASING USED: 1 Steel 2 PVC 3 RMP (SR) 4 ABS 5 Wrought iron 6 Asbestos-Cement 7 Fiberglass 8 Concrete tile 9 Other (specify below) CASING JOINTS: Glued _____ Clamped _____ Welded _____ Threaded X
Blank casing diameter: 2 in. to 21.13 ft., Dia _____ in. to _____ ft., Dia _____ in. to _____ ft.
Casing height above land surface: 0 in., weight .716 lbs./ft. Wall thickness or gauge No. .154

TYPE OF SCREEN OR PERFORATION MATERIAL: 1 Steel 2 Brass 3 Stainless steel 4 Galvanized steel 5 Fiberglass 6 Concrete tile 7 PVC 8 RMP (SR) 9 ABS 10 Asbestos-cement 11 Other (specify) _____ 12 None used (open hole)

SCREEN OR PERFORATION OPENINGS ARE: 1 Continuous slot 2 Louvered shutter 3 Mill slot 4 Key punched 5 Gauzed wrapped 6 Wire wrapped 7 Torch cut 8 Saw cut 9 Drilled holes 10 Other (specify) _____ 11 None (open hole)

SCREEN-PERFORATED INTERVALS: From 21.13 ft. to 40 ft., From _____ ft. to _____ ft., From _____ ft. to _____ ft.
GRAVEL PACK INTERVALS: From 15.5 ft. to 40 ft., From _____ ft. to _____ ft., From _____ ft. to _____ ft.

6 GROUT MATERIAL: 1 Neat cement 2 Cement grout 3 Bentonite 4 Other _____
Grout Intervals: From 0 ft. to 3 ft., From 3 ft. to 15.5 ft., From _____ ft. to _____ ft.
What is the nearest source of possible contamination: 1 Septic tank 2 Sewer lines 3 Watertight sewer lines 4 Lateral lines 5 Cess pool 6 Seepage pit 7 Pit privy 8 Sewage lagoon 9 Feedyard 10 Livestock pens 11 Fuel storage 12 Fertilizer storage 13 Insecticide storage 14 Abandoned water well 15 Oil well/Gas well 16 Other (specify below) contaminated site

FROM	TO	LITHOLOGIC LOG	FROM	TO	PLUGGING INTERVALS
0	.25	silt and clay			
.25	7	clay, trace of silt			
7	11	clay, some silt			
11	14	silt, trace clay			
14	17	silt, some clay			
17	19	silt			
19	20	silt, coarse & fine sand			
20	21.5	silt, med			
21.5	25	silt, coarse & fine sand			
25	27.5	silt, w clay			
27.5	31	silt, coarse to fine gravel			
31	35	silt, some clay			
35	40	gravel, some coarse sand			

7 CONTRACTOR'S OR LANDOWNER'S CERTIFICATION: This water well was (1) constructed, (2) reconstructed, or (3) plugged under my jurisdiction and was completed on (mo/day/year) 1-19-98 and this record is true to the best of my knowledge and belief. Kansas Water Well Contractor's License No. 554 This Water Well Record was completed on (mo/day/yr) 3-10-98 under the business name of Woolter Pump & Well, Inc by (signature) Jay C. Woolter

INSTRUCTIONS: Use typewriter or ball point pen. PLEASE PRESS FIRMLY and PRINT clearly. Please fill in blanks, underline or circle the correct answers. Send top three copies to Kansas Department of Health and Environment, Bureau of Water, Topeka, Kansas 66620-0001. Telephone: 913-296-5545. Send one to WATER WELL OWNER and retain one for your records.