


1 LOCATION OF WATER WELL: Fraction	Section Number	Township Number	Range Number
County: Washington NW 1/4 NW 1/4 NW 1/4	27	02	01 E

Distance and direction from nearest town or city street address of well if located within city?
East of Elmer between Kane & Kirkwood Streets

2 WATER WELL OWNER: KDHE	Board of Agriculture, Division of Water Resources
RR#, St. Address, Box # 1000 SW Jackson St. Ste 410	Application Number:
City, State, ZIP Code Topeka, KS 66612	

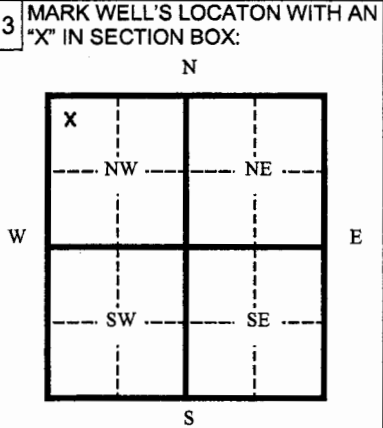

4 DEPTH OF WELL 47.3 ft. Originally completed at 48 feet .												
WELL'S STATIC WATER LEVEL 27.84 ft.												
WELL WAS USED AS:												
<table border="0"> <tr> <td>1 Domestic</td> <td>5 Public Water Supply</td> <td>9 Dewatering</td> </tr> <tr> <td>2 Irrigation</td> <td>6 Oil Field Water Supply</td> <td>10 Monitoring Well</td> </tr> <tr> <td>3 Feedlot</td> <td>7 Lawn and Garden (domestic)</td> <td>11 Injection Well</td> </tr> <tr> <td>4 Industrial</td> <td>8 Air Conditioning</td> <td>12 Other</td> </tr> </table>	1 Domestic	5 Public Water Supply	9 Dewatering	2 Irrigation	6 Oil Field Water Supply	10 Monitoring Well	3 Feedlot	7 Lawn and Garden (domestic)	11 Injection Well	4 Industrial	8 Air Conditioning	12 Other
1 Domestic	5 Public Water Supply	9 Dewatering										
2 Irrigation	6 Oil Field Water Supply	10 Monitoring Well										
3 Feedlot	7 Lawn and Garden (domestic)	11 Injection Well										
4 Industrial	8 Air Conditioning	12 Other										
Was a chemical/bacteriological sample submitted to Department? Yes ___ No X												
If yes, mo/day/yr sample was submitted _____												
Water Well Disinfected: Yes ___ No X												

5 TYPE OF BLANK CASING USED:										
<table border="0"> <tr> <td>1 Steel</td> <td>3 RMP (SR)</td> <td>5 Wrought</td> <td>7 Fiberglass</td> <td>9 Other (specify below)</td> </tr> <tr> <td>2 PVC</td> <td>4 ABC</td> <td>6 Asbestos-Cement</td> <td>8 Concrete Tile</td> <td></td> </tr> </table>	1 Steel	3 RMP (SR)	5 Wrought	7 Fiberglass	9 Other (specify below)	2 PVC	4 ABC	6 Asbestos-Cement	8 Concrete Tile	
1 Steel	3 RMP (SR)	5 Wrought	7 Fiberglass	9 Other (specify below)						
2 PVC	4 ABC	6 Asbestos-Cement	8 Concrete Tile							
Blank casing diameter 2 in. Was casing pulled? Yes X No ___ If yes, how much ~20 feet										
Casing height above or below land surface 36 in. Overdrilled to 3 feet below ground surface										

6 GROUT PLUG MATERIAL: 1 Neat cement 2 Cement grout 3 Bentonite 4 Other																				
Grout Plug Intervals From 0.5 ft. to 47.3 ft. From _____ ft. to _____ ft. From _____ ft. to _____ ft.																				
What is the nearest source of possible contamination:																				
<table border="0"> <tr> <td>1 Septic tank</td> <td>6 Seepage pit</td> <td>11 Fuel storage</td> <td>16 Other (specify below)</td> </tr> <tr> <td>2 Sewer lines</td> <td>7 Pit privy</td> <td>12 Fertilizer storage</td> <td></td> </tr> <tr> <td>3 Watertight sewer lines</td> <td>8 Sewage lagoon</td> <td>13 Insecticide storage</td> <td></td> </tr> <tr> <td>4 Lateral lines</td> <td>9 Feedyard</td> <td>14 Abandoned water well</td> <td></td> </tr> <tr> <td>5 Cess Pool</td> <td>10 Livestock pens</td> <td>15 Oil well/ Gas well</td> <td></td> </tr> </table>	1 Septic tank	6 Seepage pit	11 Fuel storage	16 Other (specify below)	2 Sewer lines	7 Pit privy	12 Fertilizer storage		3 Watertight sewer lines	8 Sewage lagoon	13 Insecticide storage		4 Lateral lines	9 Feedyard	14 Abandoned water well		5 Cess Pool	10 Livestock pens	15 Oil well/ Gas well	
1 Septic tank	6 Seepage pit	11 Fuel storage	16 Other (specify below)																	
2 Sewer lines	7 Pit privy	12 Fertilizer storage																		
3 Watertight sewer lines	8 Sewage lagoon	13 Insecticide storage																		
4 Lateral lines	9 Feedyard	14 Abandoned water well																		
5 Cess Pool	10 Livestock pens	15 Oil well/ Gas well																		
Direction from well? _____ How many feet? _____																				

FROM	TO	CODE	PLUGGING MATERIALS
0	0.5		Soil
0.5	47.3		Bentonite

7 CONTRACTOR'S OR LANDOWNER'S CERTIFICATION: This water well was plugged under my jurisdiction and was completed on (mo/day/yr) 9-8-05 and this record is true to the best of my knowledge and belief. Kansas Water Well Contractor's License No. 531 This Water Well Record was completed on (mo/day/yr) 9-28-05 under the business name of Geotechnical Services, Inc. by (signature) _____

INSTRUCTIONS: Please fill in blanks and circle the correct answers. Send three copies to Kansas Department of Health and Environment, Bureau of Water, 1000 S W Jackson St., Ste. 420, Topeka, Kansas 66620-0001. Telephone: 785-296-3565. Send one to Water Well Owner and retain one for your records.