


WATER WELL PLUGGING RECORD Form WWC-5P

KSA 82a-1212 ID NO.

MW-01

1 LOCATION OF WATER WELL: Fraction 1/4 SE 1/4 SE 1/4 SE 1/4 Section Number 18 Township Number T 32 S Range Number 1 E W
 County: Sumner
 Street/Rural Address of Well Location; if unknown, distance & direction from nearest town or intersection: If at owner's address, check here 766 E. 20th St. S
Wellington KS 67152
Global Positioning Systems (GPS) information:
 Latitude: 37.263650 (in decimal degrees)
 Longitude: -97.355689 (in decimal degrees)
 Elevation: _____
 Horizontal Datum: WGS84, NAD83, NAD27
 Collection Method: _____

2 WATER WELL OWNER: Wolcott and Lincoln
 RR#, St. Address, Box #: 4800 Main St., Ste. 565
 City, State ZIP Code: Kansas City MO 64112
 GPS unit (Make/Model: Garmin etrek)
 Digital Map/Photo, Topographic Map, Land Survey
 Est. Accuracy: < 3 m, 3-5 m, 5-15 m, > 15 m

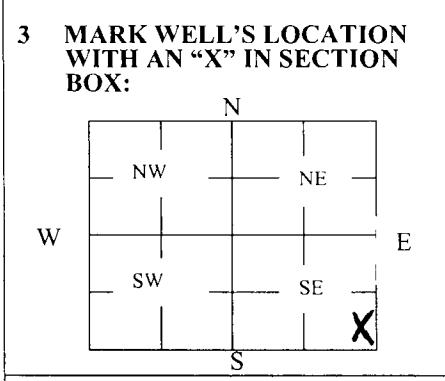

4 DEPTH OF WELL 28 ft.
 WELL'S STATIC WATER LEVEL 20 ft.
 WELL WAS USED AS:
 Domestic Public Water Supply Dewatering
 Irrigation Oil Field Water Supply Monitoring
 Feedlot Domestic (Lawn & Garden) Injection Well
 Industrial Air Conditioning Other _____
 Was a chemical/bacteriological sample submitted to Department? Yes No

5 TYPE OF BLANK CASING USED:
 Steel RMP (SR) Wrought Fiberglass Other (Specify below)
 PVC ABS Asbestos-Cement Concrete Tile
 Blank casing diameter 2 in. Was casing pulled? Yes No If yes, how much all
 Casing height above or below land surface -6 in.

6 GROUT PLUG MATERIAL: Neat cement Cement grout Bentonite Other Top Soil
 Grout Plug Intervals: From 0 ft. to 3 ft., From 3 ft. to 28 ft., From — ft. to — ft.
 What is the nearest source of possible contamination:
 Septic tank Seepage pit Fuel storage Other (specify below)
 Sewer lines Pit privy Fertilizer storage unknown
 Watertight sewer lines Sewage lagoon Insecticide storage
 Lateral lines Feedyard Abandoned water well Direction from well? unknown
 Cess pool Livestock pens Oil well/Gas well How many feet? unknown

FROM	TO	PLUGGING MATERIALS	FROM	TO	PLUGGING MATERIALS
0	3	Top Soil			
3	28	Bentonite			

7 CONTRACTOR'S OR LANDOWNER'S CERTIFICATION: This water well was plugged under my jurisdiction and was completed on (mo/day/year) 10/11/2018 and this record is true to the best of my knowledge and belief. Kansas Water Well Contractor's License No. 710. This Water Well Record was completed on (mo/day/year) 10/12/2018 under the business name of Below Ground Surface, Inc. by (signature) Craig R. Hewitt

Send one white copy to Kansas Department of Health & Environment, Geology Section, 1000 SW Jackson Street, Ste. 420, Topeka, KS 66612-1367. Send one copy to WATER WELL OWNER and retain one for your records.
 Visit us at <http://www.kdheks.gov/waterwell/index.html> Telephone 785-296-5524.

Summer


NW NW NW
SE SE SE

20-2a-1
18-32-1



LEGEND

-  Monitor Well
-  Plugged Monitor Well

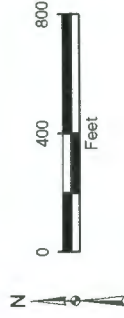

2872 NORTH RIDGE ROAD, SUITE 1028
WICHITA, KANSAS 67205
(316) 220-8070

SITE MAP

CLIENT: WOLCOTT & LINCOLN
WELLINGTON, LLC

LOCATION: WELLINGTON, KANSAS

FIGURE:
1