WATER WELL RECORD Form WWC-5 KSA 82a-1212

1 LOCATION OF WATER WELL	Fraction	Section Number	Township Number	Range Number
County: Washington	Se ¼ SW ¼ NE ¼	23	T 2 S	R 1 E/W

Distance and direction from nearest town or city? 1 east 1½ north Street address of well if located within city?
X HADDAM

2 WATER WELL OWNER: Warren Zinger
RR#, St. Address, Box # : Haddam, Kansas 66944
City, State, ZIP Code :
Board of Agriculture, Division of Water Resources
Application Number:

3 DEPTH OF COMPLETED WELL 51 ft. Bore Hole Diameter 8 in. to 51 ft., and in. to ft.
Well Water to be used as: 1 Domestic 2 Irrigation 3 Feedlot 4 Industrial 5 Public water supply 6 Oil field water supply 7 Lawn and garden only 8 Air conditioning 9 Dewatering 10 Observation well 11 Injection well 12 Other (Specify below)
Well's static water level 36 ft. below land surface measured on September month 28 day 1979 year
Pump Test Data : Well water was na ft. after na hours pumping gpm
Est. Yield 15 gpm: Well water was ft. after hours pumping gpm

4 TYPE OF BLANK CASING USED: 1 Steel 2 PVC 3 RMP (SR) 4 ABS 5 Wrought iron 6 Asbestos-Cement 7 Fiberglass 8 Concrete tile 9 Other (specify below)
Casing Joints: Glued X Clamped Welded Threaded
Blank casing dia 5 in. to 31 ft., Dia in. to ft., Dia in. to ft.
Casing height above land surface 12 in., weight 3 lbs./ft. Wall thickness or gauge No .258
TYPE OF SCREEN OR PERFORATION MATERIAL: 1 Steel 2 Brass 3 Stainless steel 4 Galvanized steel 5 Fiberglass 6 Concrete tile 7 PVC 8 RMP (SR) 9 ABS 10 Asbestos-cement 11 Other (specify) 12 None used (open hole)
Screen or Perforation Openings Are: 1 Continuous slot 2 Louvered shutter 3 Mill slot 4 Key punched 5 Gauzed wrapped 6 Wire wrapped 7 Torch cut 8 Saw cut 9 Drilled holes 10 Other (specify) 11 None (open hole)
Screen-Perforation Dia 5 in. to ft., Dia in. to ft., Dia in to ft.
Screen-Perforated Intervals: From 31 ft. to 51 ft., From ft. to ft.
From ft. to ft., From ft. to ft.
Gravel Pack Intervals: From 10 ft. to 51 ft., From ft. to ft.
From ft. to ft., From ft. to ft.

5 GROUT MATERIAL: 1 Neat cement 2 Cement grout 3 Bentonite 4 Other
Grouted Intervals: From 0 ft. to 10 ft., From ft. to ft., From ft. to ft.
What is the nearest source of possible contamination: 1 Septic tank 2 Sewer lines 3 Lateral lines 4 Cess pool 5 Seepage pit 6 Pit privy 7 Sewage lagoon 8 Feed yard 9 ~~Livestock pens~~ 10 Fuel storage 11 Fertilizer storage 12 Insecticide storage 13 Watertight sewer lines 14 Abandoned water well 15 Oil well/Gas well 16 Other (specify below)
Direction from well West How many feet 50 ? Water Well Disinfected? Yes X No
Was a chemical/bacteriological sample submitted to Department? Yes No X If yes, date sample was submitted month day year: Pump Installed? Yes No X
If Yes: Pump Manufacturer's name Model No. HP Volts
Depth of Pump Intake ft. Pumps Capacity rated at gal./min.
Type of pump: 1 Submersible 2 Turbine 3 Jet 4 Centrifugal 5 Reciprocating 6 Other

6 CONTRACTOR'S OR LANDOWNER'S CERTIFICATION: This water well was (X) constructed, (2) reconstructed, or (3) plugged under my jurisdiction and was completed on September month 28 day 1979 year and this record is true to the best of my knowledge and belief. Kansas Water Well Contractor's License No. 359
This Water Well Record was completed on September month 30 day 79 year under the business name of Daryl Cox & Sons Inc. by (signature) Daryl Cox

7 LOCATE WELL'S LOCATION WITH AN "X" IN SECTION BOX:

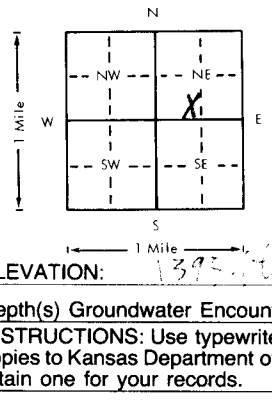

FROM	TO	LITHOLOGIC LOG	FROM	TO	LITHOLOGIC LOG
0	3	Topsoil			
3	31	Brown Cly			
31	37	Blue Clay			
37	46	Gravel			
46	48	Blue Clay			
48	49	Red Clay			
49	51	Blue Clay			
	51	Stop			

ELEVATION: 1395 ft

DRILLED W/ WATER

Depth(s) Groundwater Encountered 1 ft. 2 ft. 3 ft. 4 ft. (Use a second sheet if needed)

INSTRUCTIONS: Use typewriter or ball point pen, *please press firmly* and *PRINT* clearly. Please fill in blanks, underline or circle the correct answers. Send top three copies to Kansas Department of Health and Environment, Division of Environment, Water Well Contractors, Topeka, KS 66620. Send one to WATER WELL OWNER and retain one for your records.

OFFICE USE ONLY