

WATER WELL RECORD Form WWC-5

Original Record Correction Change in Well Use

Division of Water Resources App. No.

Well ID

Well ID

1 LOCATION OF WATER WELL: County: Fraction Section Number Township Number Range Number
2 WELL OWNER: Last Name: Business: Address: City: State: ZIP: Street or Rural Address where well is located
3 LOCATE WELL WITH "X" IN SECTION BOX: N W E S
4 DEPTH OF COMPLETED WELL: Depth(s) Groundwater Encountered: WELL'S STATIC WATER LEVEL: Pump test data: Estimated Yield: Bore Hole Diameter:
5 Latitude: Longitude: Datum: Source for Latitude/Longitude: Elevation: Source:

7 WELL WATER TO BE USED AS: 1. Domestic: 2. Irrigation: 3. Feedlot: 4. Industrial: 5. Public Water Supply: 6. Dewatering: 7. Aquifer Recharge: 8. Monitoring: 9. Environmental Remediation: 10. Oil Field Water Supply: 11. Test Hole: 12. Geothermal: 13. Other (specify):


Was a chemical/bacteriological sample submitted to KDHE? Water well disinfected?

8 TYPE OF CASING USED: CASING JOINTS: TYPE OF SCREEN OR PERFORATION MATERIAL: SCREEN OR PERFORATION OPENINGS ARE: SCREEN-PERFORATED INTERVALS: GRAVEL PACK INTERVALS:

9 GROUT MATERIAL: Grout Intervals: Nearest source of possible contamination: Direction from well? Distance from well?

Table with 6 columns: FROM, TO, LITHOLOGIC LOG, FROM, TO, LITHO. LOG (cont.) or PLUGGING INTERVALS. Includes a Notes section.

11 CONTRACTOR'S OR LANDOWNER'S CERTIFICATION: This water well was constructed, reconstructed, or plugged under my jurisdiction and was completed on (mo-day-year) and this record is true to the best of my knowledge and belief.

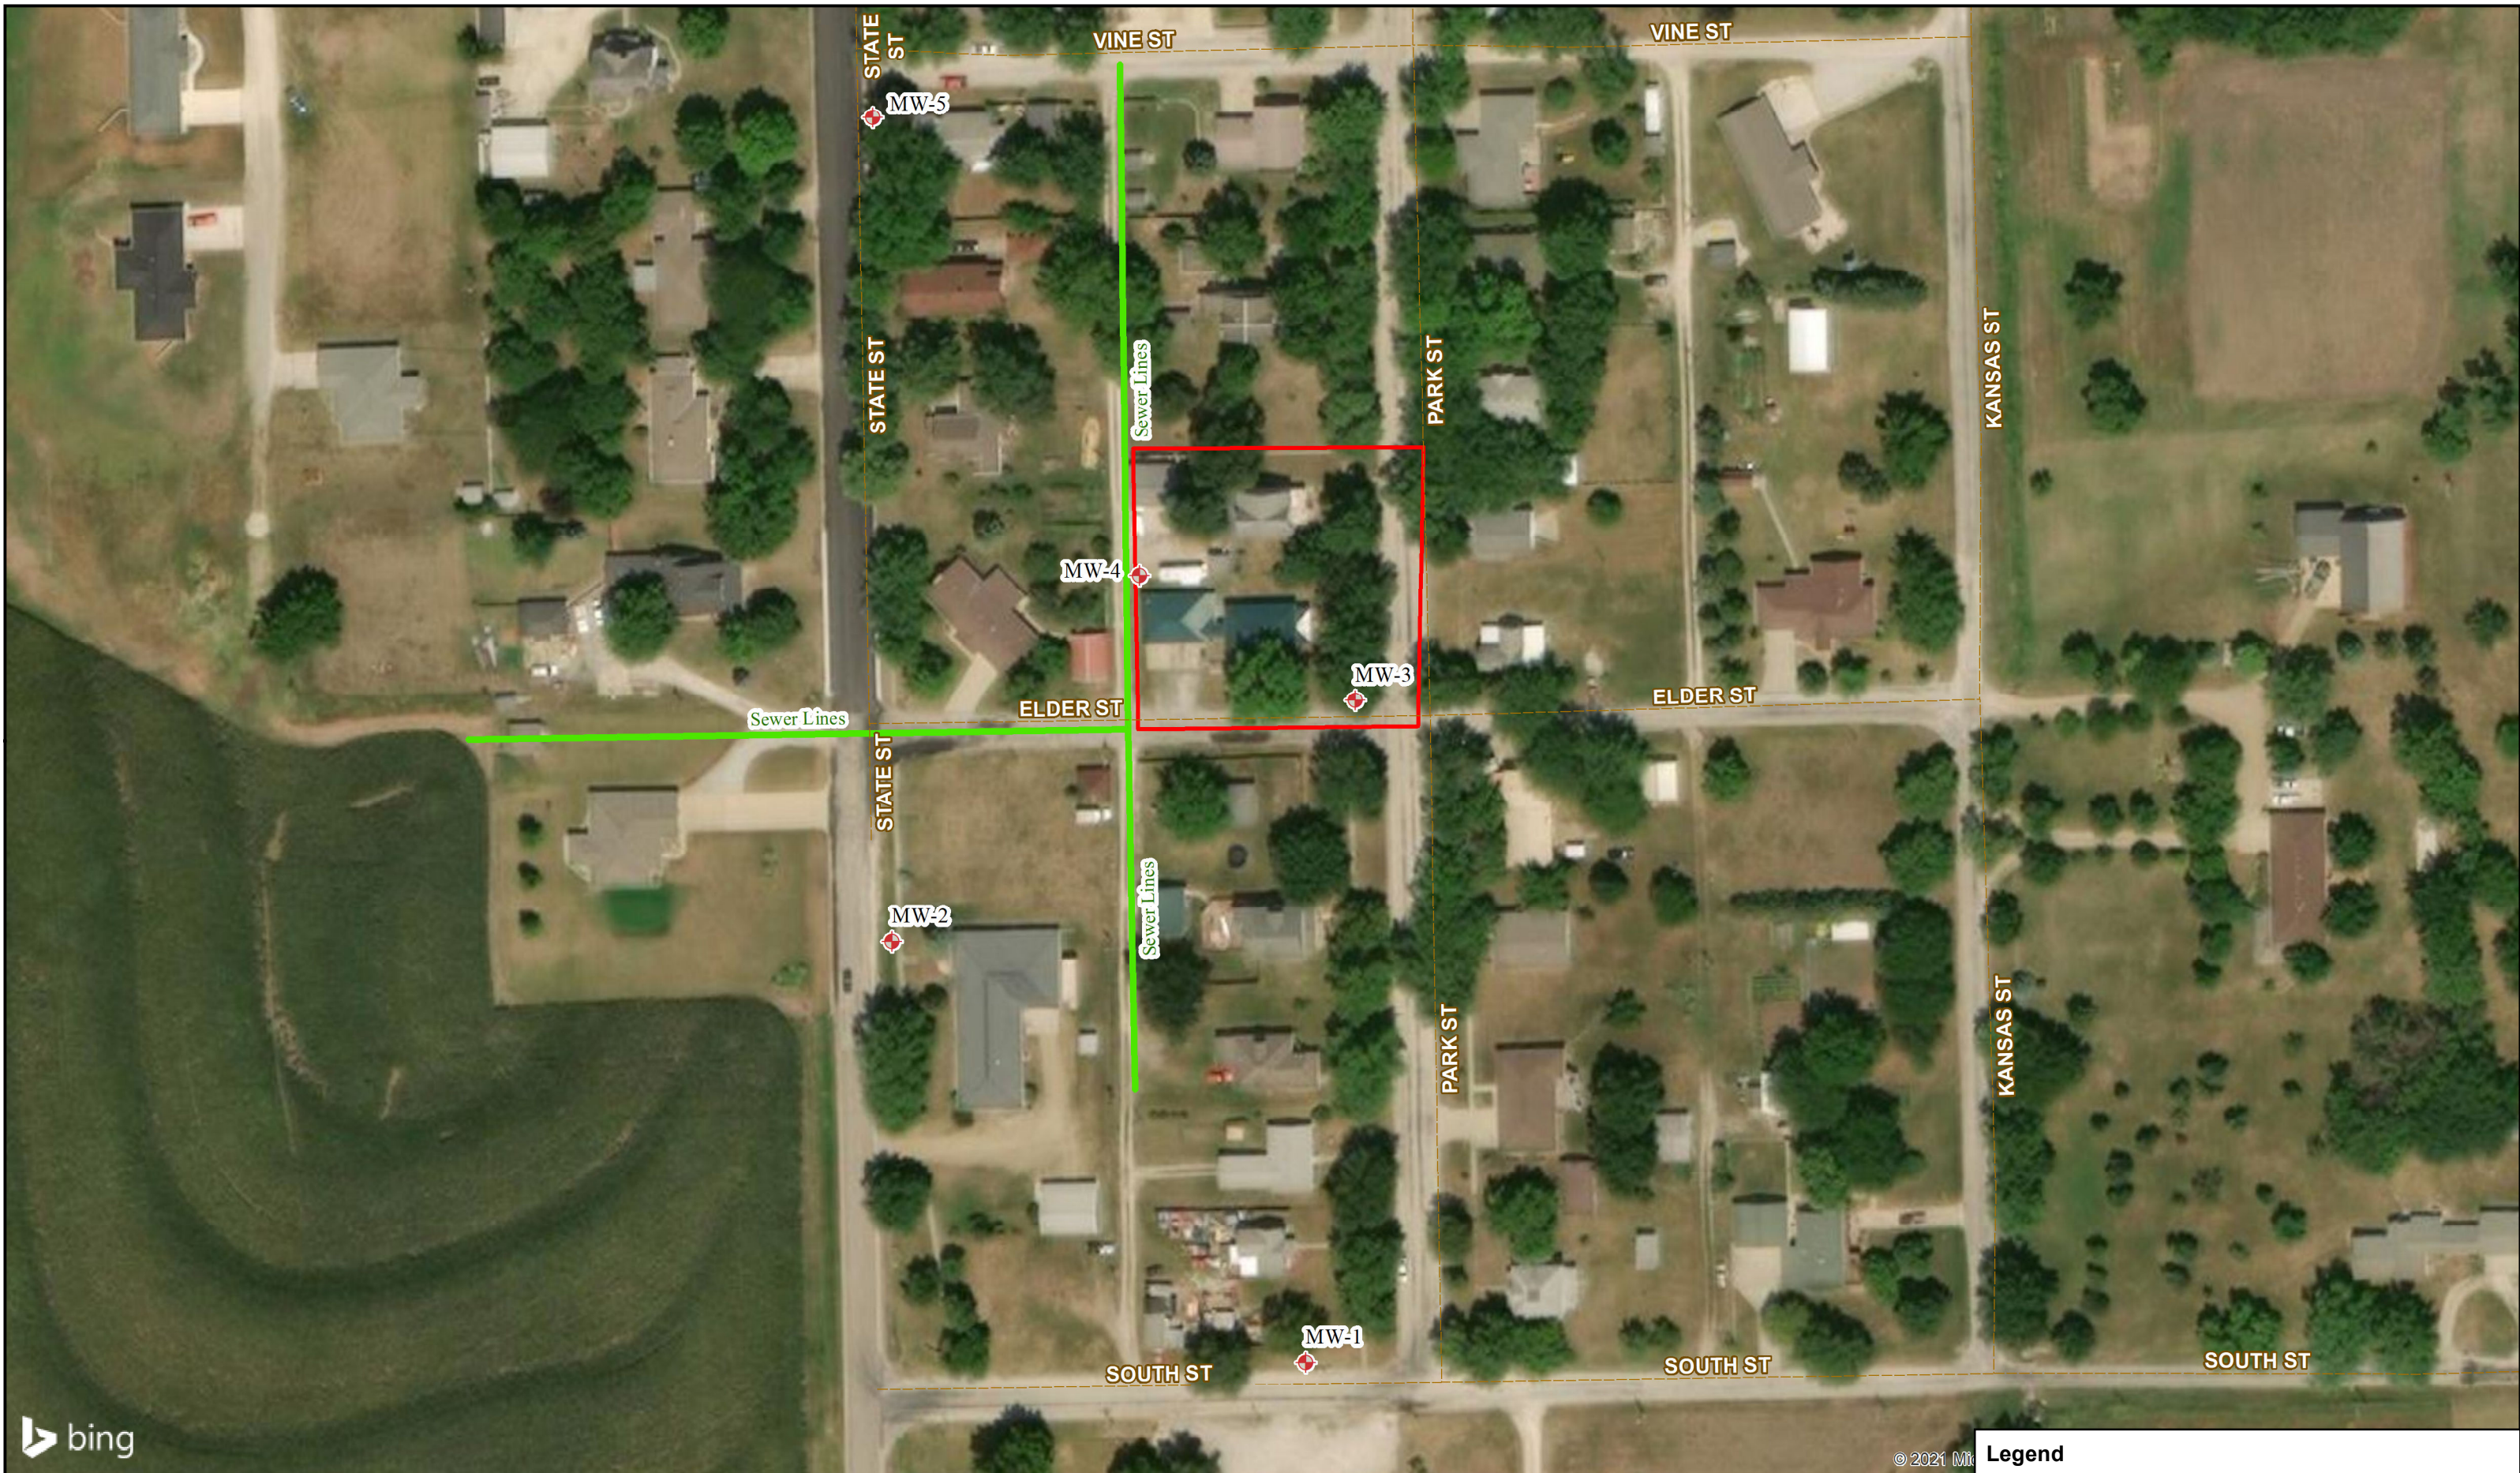

bing

© 2021 Microsoft

	FIGURE: <b>5.0</b>	FIGURE NAME: <b>Monitoring Well Locations</b>	<b>Axtell PWS #2 Site</b> <b>Axtell, Kansas</b> <b>KDHE # C4-058-00004</b>	 1 in = 100 feet 	<b>Legend</b> Monitoring Well  Approximate Site Location Roads Sewer Lines ALL BOUNDARIES AND LOCATIONS ARE APPROXIMATE
	DATE: <b>09/24/2021</b>	PROJECT NUMBER: <b>1874209</b>			
	DRAWN BY: <b>HS</b>	PROJECT MANAGER: <b>KWHEELER</b>			