

WATER WELL RECORD


Form WWC-5

Division of Water Resources App. No.

1 LOCATION OF WATER WELL: County: Nemaha Fraction SE 1/4 SE 1/4 SE 1/4 SE 1/4 Section Number 34 Township No. T 2 S Range Number R 11 E W

Street/Rural Address of Well Location; if unknown, distance & direction from nearest town or intersection: If at owner's address, check here 144th Rd. and E rd. Global Positioning System (GPS) information: Latitude: 39.49646 Longitude: 96.09846 Elevation: 1273

2 WATER WELL OWNER: United States Geological Survey RR#, Street Address, Box #: 4821 Quail Crest Place City, State, ZIP Code : Lawrence, KS 66049

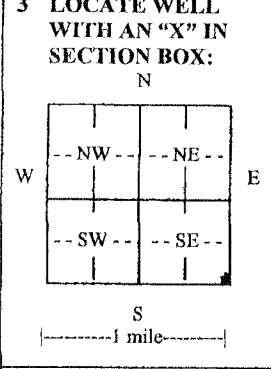

3 LOCATE WELL WITH AN 'X' IN SECTION BOX: 4 DEPTH OF COMPLETED WELL 23.5 ft. Depth(s) Groundwater Encountered (1) 12 ft. (2) ft. (3) ft. WELL'S STATIC WATER LEVEL 12 ft. below land surface measured on mo/day/yr 9/17/10

5 TYPE OF CASING USED: Steel PVC Other CASING JOINTS: Glued Clamped Welded Threaded Casing diameter 2.5 in. to 23.5 ft., Diameter in. to ft., Diameter in. to ft. Casing height above land surface 30 in., Weight lbs./ft., Wall thickness or gauge No. schedule 80

6 GROUT MATERIAL: Neat cement Cement grout Bentonite Other Grout Intervals: From surface ft. to 13 ft., From ft. to ft., From ft. to ft. What is the nearest source of possible contamination: Septic tank Lateral lines Pit privy Livestock pens Insecticide storage Other (specify below)

Table with columns: FROM, TO, LITHOLOGIC LOG, FROM, TO, LITHO. LOG (cont.) or PLUGGING INTERVALS. Row 1: 0, 12, Brown clay. Row 2: 12, 23.5, Brown silt and sand.

7 CONTRACTOR'S OR LANDOWNER'S CERTIFICATION: This water well was constructed, reconstructed, or plugged under my jurisdiction and was completed on (mo/day/year) 9/17/10 and this record is true to the best of my knowledge and belief.

INSTRUCTIONS: Use typewriter or ball point pen. PLEASE PRESS FIRMLY and PRINT clearly. Please fill in blanks and check the correct answers. Send three copies (white, blue, pink) to Kansas Department of Health and Environment, Bureau of Water, Geology Section, 1000 SW Jackson St., Suite 420, Topeka, Kansas 66612-1367.