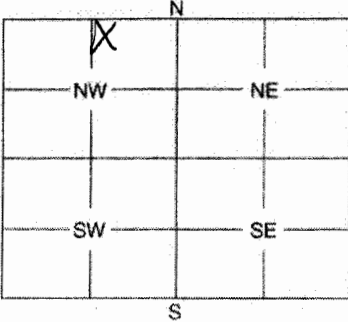


1 LOCATION OF WATER WELL: County: Nemaha	Fraction NW ¹/₄ NE ¹/₄ NW ¹/₄	Section Number 34	Township Number 2S	Range Number 12E
---	---	-----------------------------	------------------------------	----------------------------

Distance and direction from nearest town or city street address of well if located within city?
Coastal Mart #9100 Seneca, Kansas

2 WATER WELL OWNER: Coastal Mart #9100 RR #, St. Address, Box #: 2 North Nevada City, State, ZIP Code: Colorado Springs, CO 80903	Board of Agriculture, Division of Water Resources Application Number:
---	--

3 MARK WELL'S LOCATION WITH AN "X" IN SECTION BOX: 	4 DEPTH OF WELL 28.11 ft. WELL'S STATIC WATER LEVEL .27.74 ... ft. WELL WAS USED AS: <table style="width:100%; border: none;"> <tr> <td style="width:33%;">1 Domestic</td> <td style="width:33%;">5 Public Water Supply</td> <td style="width:33%;">9 Dewatering</td> </tr> <tr> <td>2 Irrigation</td> <td>6 Oil Field Water Supply</td> <td>10 Monitoring Well</td> </tr> <tr> <td>3 Feedlot</td> <td>7 Domestic (Lawn & Garden)</td> <td>11 Injection Well</td> </tr> <tr> <td>4 Industrial</td> <td>8 Air Conditioning</td> <td>12 Other</td> </tr> </table> Was a chemical / bacteriological sample submitted to Department? Yes No X If yes, mo/day/yr sample was submitted	1 Domestic	5 Public Water Supply	9 Dewatering	2 Irrigation	6 Oil Field Water Supply	10 Monitoring Well	3 Feedlot	7 Domestic (Lawn & Garden)	11 Injection Well	4 Industrial	8 Air Conditioning	12 Other
1 Domestic	5 Public Water Supply	9 Dewatering											
2 Irrigation	6 Oil Field Water Supply	10 Monitoring Well											
3 Feedlot	7 Domestic (Lawn & Garden)	11 Injection Well											
4 Industrial	8 Air Conditioning	12 Other											

5 TYPE OF BLANK CASING USED:

1 Steel	3 RMP (SR)	5 Wrought	7 Fiberglass	9 Other (Specify below)
2 PVC	4 ABS	6 Asbestos-Cement	8 Concrete Tile	

Blank casing diameter in. Was casing pulled? Yes **X**..... No If yes, how much **20'**.....
 Casing height above or below land surface in.

6 GROUT PLUG MATERIAL: **3** Neat cement 2 Cement grout **3** Bentonite **4** Other **Concrete**

Grout Plug Intervals: From **20** ft. to **2** ft., From **2** ft. to **0** ft., From to ft.

What is the nearest source of possible contamination:

1 Septic tank	6 Seepage pit	11 Fuel storage
2 Sewer lines	7 Pit privy	12 Fertilizer storage
3 Watertight sewer lines	8 Sewage lagoon	13 Insecticide storage
4 Lateral lines	9 Feedyard	14 Abandoned water well
5 Cess pool	10 Livestock pens	15 Oil well/Gas well

Direction from well? How many feet?

FROM	TO	PLUGGING MATERIALS
20	2	Bentonite
2	0	Concrete
		overdrilled to 20'

RECEIVED

OCT 16 2006

BUREAU OF WATER

7 CONTRACTOR'S OF LANDOWNER'S CERTIFICATION: This water well was plugged under my jurisdiction and was completed on (mo/day/year) **09/15/06** and this record is true to the best of my knowledge and belief. Kansas Water Well Contractor's License No. **585**. This Water Well Record was completed on (mo/day/year) **10/02/06** under the business name of **Associated Environmental, Inc.**
 by (signature) **B. Johnson**

INSTRUCTIONS: Use typewriter or ball point pen. Please press firmly and print clearly. Please fill in blanks, underline or circle the correct answers. Send top three copies to Kansas Department of Health and Environment, Bureau of Water, Geology Section, 1000 SW Jackson St., Ste. 420, Topeka, Kansas 66612-1367. Telephone: 785/296-5522. Send one to Water Well Owner and retain one for your records.