


WATER WELL RECORD Form WWC-5 KSA 82a-1212

1 LOCATION OF WATER WELL: Fraction SW 1/4 SW 1/4 SE 1/4 Section Number 1 Township Number T 2 S Range Number R 12 E/W
 County: NEMAHA

Distance and direction from nearest town or city street address of well if located within city?
 4 1/2 west, 2 north of Oneida

2 WATER WELL OWNER: Mark Fangman
 RR#, St. Address, Box # : 309 N. 6th Board of Agriculture, Division of Water Resources
 City, State, ZIP Code : Seneca, KS 66538 Application Number:

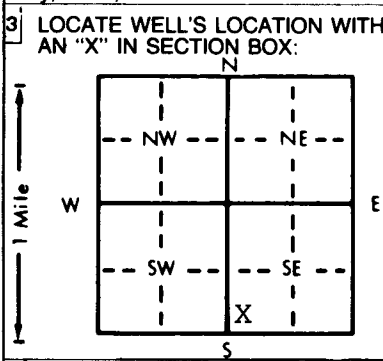

4 DEPTH OF COMPLETED WELL... 75' ft. ELEVATION:
 Depth(s) Groundwater Encountered 1... 25' ft. 2... ft. 3... ft.
 WELL'S STATIC WATER LEVEL... 20' ft. below land surface measured on mo/day/yr 5-14-92
 Pump test data: Well water was ... ft. after ... hours pumping ... gpm
 Est. Yield .2... gpm: Well water was ... ft. after ... hours pumping ... gpm
 Bore Hole Diameter... 12" in. to ... ft., and ... in. to ... ft.
 WELL WATER TO BE USED AS: 5 Public water supply 8 Air conditioning 11 Injection well
 1 Domestic 3 Feedlot 6 Oil field water supply 9 Dewatering 12 Other (Specify below)
 2 Irrigation 4 Industrial 7 Lawn and garden only 10 Monitoring well
 Was a chemical/bacteriological sample submitted to Department? Yes... No... ; If yes, mo/day/yr sample was submitted
 Water Well Disinfected? Yes No

5 TYPE OF BLANK CASING USED: 5 Wrought iron 8 Concrete tile CASING JOINTS: Glued Clamped
 1 Steel 3 RMP (SR) 6 Asbestos-Cement 9 Other (specify below) Welded
 2 PVC 4 ABS 7 Fiberglass Threaded
 Blank casing diameter... 5" in. to... 0-16 ft., Dia... 5" in. to... 36-74 ft., Dia... in. to... ft.
 Casing height above land surface... 24" in., weight... 2.82 lbs./ft. Wall thickness or gauge No. ... 258
 TYPE OF SCREEN OR PERFORATION MATERIAL: 7 PVC 10 Asbestos-cement
 1 Steel 3 Stainless steel 5 Fiberglass 8 RMP (SR) 11 Other (specify)
 2 Brass 4 Galvanized steel 6 Concrete tile 9 ABS 12 None used (open hole)
 SCREEN OR PERFORATION OPENINGS ARE: 5 Gauzed wrapped 8 Saw cut 11 None (open hole)
 1 Continuous slot 3 Mill slot 6 Wire wrapped 9 Drilled holes
 2 Louvered shutter 4 Key punched 7 Torch cut 10 Other (specify)
 SCREEN-PERFORATED INTERVALS: From... 16 ft. to... 36 ft., From... ft. to... ft.
 From... 74 ft. to... 75 ft., From... ft. to... ft.
 GRAVEL PACK INTERVALS: From... 20 ft. to... 75 ft., From... ft. to... ft.
 From... ft. to... ft., From... ft. to... ft.

6 GROUT MATERIAL: 1 Neat cement 2 Cement grout 3 Bentonite 4 Other
 Grout Intervals: From... 0 ft. to... 20 ft., From... ft. to... ft., From... ft. to... ft.
 What is the nearest source of possible contamination:
 1 Septic tank 4 Lateral lines 7 Pit privy 10 Livestock pens 14 Abandoned water well
 2 Sewer lines 5 Cess pool 8 Sewage lagoon 11 Fuel storage 15 Oil well/Gas well
 3 Watertight sewer lines 6 Seepage pit 9 Feedyard 12 Fertilizer storage 16 Other (specify below)
 13 Insecticide storage
 Direction from well? east How many feet? 1/4 mile

FROM	TO	LITHOLOGIC LOG	FROM	TO	PLUGGING INTERVALS
0	22	Clay-Brown			
22	33	Clay-Blue			
33	35	Shale-Grey			
35	38	Limestone-Grey			
38	41	Shale-Grey			
41	58	Limestone-Grey			
58	61	Shale-Grey			
61	75	Limestone-Grey			

7 CONTRACTOR'S OR LANDOWNER'S CERTIFICATION: This water well was (1) constructed, (2) reconstructed, or (3) plugged under my jurisdiction and was completed on (mo/day/year) 5-14-92 and this record is true to the best of my knowledge and belief. Kansas Water Well Contractor's License No. 182 This Water Well Record was completed on (mo/day/yr) 6-8-92 under the business name of STRADER DRILLING CO., INC. by (signature) Dale Bohren