

WATER WELL RECORD

Form WWC-5


MW2

Division of Water Resources App. No.

1 LOCATION OF WATER WELL: County: Neyaha, Fraction 1/4 SW 1/4 SW 1/4 NE 1/4, Section Number 34, Township No. T 2 S, Range Number R 12 E

Street/Rural Address of Well Location: New Bldg: 11 North 3rd Street Seneca, Ks. Global Positioning System (GPS) information: Latitude: 39.83472 N, Longitude: 96.65981 W

2 WATER WELL OWNER: KDHE-BER, RR#, Street Address, Box #: 1000 SW Jackson Topeka, Ks. 66612. Collection Method: Land Survey

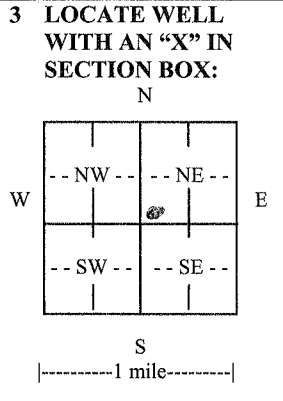

4 DEPTH OF COMPLETED WELL 33' ft. Depth(s) Groundwater Encountered (1) 24' ft. (2) 23.5' ft. (3) 23.5' ft. EST. YIELD: 7 gpm. Well water was 33' ft. after 10/28/10 hours pumping. Bore Hole Diameter 7 1/2 in. to 33' ft. and 33' in. to 33' ft. WELL WATER TO BE USED AS: Monitoring well

5 TYPE OF CASING USED: PVC. CASING JOINTS: Threaded. Casing diameter 2.375 in. to 18' ft., Diameter 18' in. to 18' ft., Diameter 18' in. to 18' ft. Casing height above land surface 40 in., Weight 40 lbs./ft., Wall thickness or gauge No. sch 40

TYPE OF SCREEN OR PERFORATION MATERIAL: PVC. SCREEN OR PERFORATION OPENINGS ARE: Mill slot. SCREEN-PERFORATED INTERVALS: From 33' ft. to 18' ft., From 18' ft. to 18' ft., From 18' ft. to 18' ft. GRAVEL PACK INTERVALS: From 33' ft. to 16' ft., From 16' ft. to 16' ft., From 16' ft. to 16' ft.

6 GROUT MATERIAL: Bentonite. Grout Intervals: From 16' ft. to 1' ft., From 1' ft. to 0' ft., From 0' ft. to 0' ft. What is the nearest source of possible contamination: Septic tank, Lateral lines, Pit privy, Livestock pens, Insecticide storage, Other (specify below)

Table with columns: FROM, TO, LITHOLOGIC LOG, FROM, TO, LITHO. LOG (cont.) or PLUGGING INTERVALS. Rows describe geological layers: yellow br silty clay, stiff; reddish br sandy clay w/ black streaks, hard, soft; yellow br medium sand, soft; yellow br silty sandy clay, med, soft.

7 CONTRACTOR'S OR LANDOWNER'S CERTIFICATION: This water well was constructed, reconstructed, or plugged under my jurisdiction and was completed on (mo/day/year) 10/28/10... and this record is true to the best of my knowledge and belief. Kansas Water Well Contractor's License No. 732. This Water Well Record was completed on (mo/day/year) 11/23/10 under the business name of JB Environmental by (signature) James Buckle

INSTRUCTIONS: Use typewriter or ball point pen. PLEASE PRESS FIRMLY and PRINT clearly. Please fill in blanks and check the correct answers. Send three copies (white, blue, pink) to Kansas Department of Health and Environment, Bureau of Water, Geology Section, 1000 SW Jackson St., Suite 420, Topeka, Kansas 66612-1367. Telephone 785-296-5522. Send one copy to WATER WELL OWNER and retain one for your records. Include fee of \$5.00 for each constructed well. Visit us at http://www.kdheks.gov/waterwell/index.html.