

MW4

WATER WELL RECORD


Form WWC-5

Division of Water Resources App. No.

1 LOCATION OF WATER WELL: County: Nemaha, Fraction: 1/4 SW 1/4 SW 1/4 NE 1/4, Section Number: 34, Township No. T 2 S, Range Number R 12 E

Street/Rural Address of Well Location: New Bldg: 11 North 3rd Street Seneca, Ks. Global Positioning System (GPS) information: Latitude: 39.83439N, Longitude: 96.05972W

2 WATER WELL OWNER: KDHE-BER, RR#, Street Address, Box #: 1000 SW Jackson Topeka, Ks. 66612, Collection Method: Land Survey

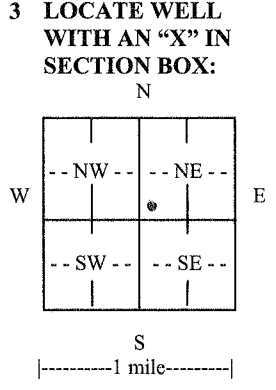

4 DEPTH OF COMPLETED WELL: 35' ft. Depth(s) Groundwater Encountered: 30' ft. WELL'S STATIC WATER LEVEL: 30.71 ft. below land surface measured on 10/23/10. Pump test data: Well water was 10/23/10 after 10 hours pumping. EST. YIELD: 100 gpm. Bore Hole Diameter: 7 1/2" in. to 35' ft. WELL WATER TO BE USED AS: Monitoring well. Was a chemical/bacteriological sample submitted? No. Water well disinfected? No.

5 TYPE OF CASING USED: PVC. CASING JOINTS: Threaded. Casing diameter: 2.375 in. to 20' ft., Diameter: 1 in. to 1 in. Casing height above land surface: Flush Mt. in., Weight: lbs./ft., Wall thickness or gauge No. Sch 40.

TYPE OF SCREEN OR PERFORATION MATERIAL: PVC. SCREEN OR PERFORATION OPENINGS ARE: Mill slot. SCREEN-PERFORATED INTERVALS: From 35' ft. to 20' ft. GRAVEL PACK INTERVALS: From 35' ft. to 18' ft.

6 GROUT MATERIAL: Bentonite, Other Cement. Grout Intervals: From 18' ft. to 1' ft., From 1' ft. to 0' ft., From 0' ft. to 0' ft. What is the nearest source of possible contamination: Septic tank, Lateral lines, Pit privy, Livestock pens, Insecticide storage, Other (specify below).

Table with columns: FROM, TO, LITHOLOGIC LOG, FROM, TO, LITHO. LOG (cont.) or PLUGGING INTERVALS. Rows describe geological layers: 0-14' dk yellow brn silty clay, moist, firm; 14-16' reddish brn sandy clay, moist, soft; 16-28' yellow brn medium sand, hard, soft; 28-35' yellow brn sandy clay, moist to wet.

7 CONTRACTOR'S OR LANDOWNER'S CERTIFICATION: This water well was constructed, reconstructed, or plugged under my jurisdiction and was completed on (mo/day/year) 10/23/10 and this record is true to the best of my knowledge and belief. Kansas Water Well Contractor's License No. 132. This Water Well Record was completed on (mo/day/year) 11/23/10 under the business name of JB Environmental by (signature) James Burkett.

INSTRUCTIONS: Use typewriter or ball point pen. PLEASE PRESS FIRMLY and PRINT clearly. Please fill in blanks and check the correct answers. Send three copies (white, blue, pink) to Kansas Department of Health and Environment, Bureau of Water, Geology Section, 1000 SW Jackson St., Suite 420, Topeka, Kansas 66612-1367. Telephone 785-296-5522. Send one copy to WATER WELL OWNER and retain one for your records. Include fee of \$5.00 for each constructed well. Visit us at http://www.kdheks.gov/waterwell/index.html.