

WATER WELL RECORD

Form WWC-5

MW-13


Division of Water Resources App. No.

Empty box for application number

1 LOCATION OF WATER WELL: County: Nemaha, Fraction 1/4 SE 1/4 NE 1/4, Section Number 34, Township No. T 2 S, Range Number R 12 E W

Street/Rural Address of Well Location; if unknown, distance & direction from nearest town or intersection: If at owner's address, check here [X]. Global Positioning System (GPS) information: Latitude: 39.8366, Longitude: 96.0511, Elevation: [blank], Datum: [X] WGS 84, [] NAD 83, [] NAD 27

2 WATER WELL OWNER: Nemaha County Coop Assn. RR#, Street Address, Box #: 223 E. Main St. City, State, ZIP Code: Seneca, KS 66538. Collection Method: [X] GPS unit (Make/Model: Garmin 60C), [] Digital Map/Photo, [] Topographic Map, [] Land Survey. Est. Accuracy: [] <3 m, [X] 3-5 m, [] 5-15 m, [] >15 m

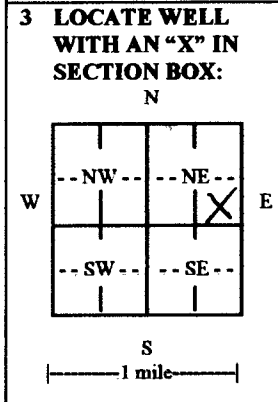

3 LOCATE WELL WITH AN 'X' IN SECTION BOX: [Diagram]. 4 DEPTH OF COMPLETED WELL 16 ft. Depth(s) Groundwater Encountered (1) 6 ft. (2) [blank] ft. (3) [blank] ft. WELL'S STATIC WATER LEVEL [blank] ft. below land surface measured on mo/day/yr. Pump test data: Well water was [blank] ft. after [blank] hours pumping [blank] gpm. EST. YIELD [blank] gpm. Well water was [blank] ft. after [blank] hours pumping [blank] gpm. Bore Hole Diameter 8 in. to 16 ft., and [blank] in. to [blank] ft. WELL WATER TO BE USED AS: [] Public water supply, [] Geothermal, [] Injection well, [] Domestic, [] Feedlot, [] Oil field water supply, [] Dewatering, [] Other (Specify below), [] Irrigation, [] Industrial, [] Domestic-lawn & garden, [X] Monitoring well. Was a chemical/bacteriological sample submitted to Department? [] Yes, [X] No. If yes, mo/day/yr sample was submitted [blank]. Water well disinfected? [] Yes, [X] No

5 TYPE OF CASING USED: [] Steel, [X] PVC, [] Other. CASING JOINTS: [] Glued, [] Clamped, [] Welded, [X] Threaded. Casing diameter 2 in. to 6 ft., Diameter [blank] in. to [blank] ft., Diameter [blank] in. to [blank] ft. Casing height above land surface 30 in., Weight [blank] lbs./ft., Wall thickness or gauge No. Sch. 40. TYPE OF SCREEN OR PERFORATION MATERIAL: [] Steel, [] Stainless Steel, [X] PVC, [] Other (Specify) [blank], [] Brass, [] Galvanized Steel, [] None used (open hole). SCREEN OR PERFORATION OPENINGS ARE: [] Continuous slot, [X] Mill slot, [] Gauze wrapped, [] Torch cut, [] Drilled holes, [] None (open hole), [] Louvered shutter, [] Key punched, [] Wire wrapped, [] Saw cut, [] Other (specify) [blank]. SCREEN-PERFORATED INTERVALS: From 16 ft. to 6 ft., From [blank] ft. to [blank] ft., From [blank] ft. to [blank] ft. GRAVEL PACK INTERVALS: From 16 ft. to 4 ft., From [blank] ft. to [blank] ft., From [blank] ft. to [blank] ft.

6 GROUT MATERIAL: [] Neat cement, [] Cement grout, [X] Bentonite, [] Other. Grout Intervals: From 4 ft. to 2 ft., From [blank] ft. to [blank] ft., From [blank] ft. to [blank] ft., From [blank] ft. to [blank] ft. What is the nearest source of possible contamination: [] Septic tank, [] Lateral lines, [] Pit privy, [] Livestock pens, [] Insecticide storage, [] Other (specify below), [] Sewer lines, [] Cesspool, [] Sewage lagoon, [X] Fuel storage, [] Abandoned water well, [] Watertight sewer lines, [] Seepage pit, [] Feedyard, [] Fertilizer storage, [] Oil well/gas well. Direction from well [blank], Distance from well [blank]

Table with columns: FROM, TO, LITHOLOGIC LOG, FROM, TO, LITHO. LOG (cont.) or PLUGGING INTERVALS. Row 1: 0, 13, Silty Clay. Row 2: 13, 16, Silty Clay w/Fine Sand.

7 CONTRACTOR'S OR LANDOWNER'S CERTIFICATION: This water well was [X] constructed, [] reconstructed, or [] plugged under my jurisdiction and was completed on (mo/day/year) 2/27/2014 and this record is true to the best of my knowledge and belief. Kansas Water Well Contractor's License No. 710. This Water Well Record was completed on (mo/day/year) 3/17/2014 under the business name of Below Ground Surface, Inc. by (signature) [Signature]

INSTRUCTIONS: Use typewriter or ball point pen. PLEASE PRESS FIRMLY and PRINT clearly. Please fill in blanks and check the correct answers. Send three copies (white, blue, pink) to Kansas Department of Health and Environment, Bureau of Water, Geology Section, 1000 SW Jackson St., Suite 420, Topeka, Kansas 66612-1367.