
WATER WELL R		WWC-5		sion of Water			MW-10			
Original Record		ge in Well Use		urces App. No.	T	Well ID				
1 LOCATION OF W.	ATER WELL:	Fraction		tion Number	Township Number					
County: Nemaha	11000	NE 14 NW 14 NW 1								
2 WELL OWNER: Last Name: First: Street or Rural Address where well is located (if unknown, distance and										
Business: Seneca C			direction from r	earest town or inte	ersection): If at owner	's address, che	ck here:			
Address: 304 Main S Address:	Street		304 Main St	reet			(			
City: Seneca	State: KS	ZIP: 66538	Seneca, KS 66538							
3 LOCATE WELL				5 Latitude: 39.83348 (decimal degrees)						
WITH "X" IN	4 DEPTH OF COM			5 Latitude	39.83340	5(dec	cimal degrees)			
SECTION BOX:	Depth(s) Groundwater			Longitue	de:96.059	08(dex	cimal degrees)			
N		3) <b>N/A</b> ft., or 4)			d Datum: ☐ WGS 84		□ NAD 27			
	WELL'S STATIC WA  below land surface				r Latitude/Longitude:					
,   ,		, measured on (mo-day			(unit make/model: (WAAS enabled? □					
NW NE	Pump test data: Well v									
W E	afterN/A hour	s pumping N/A	gpm	☐ Land Survey ☐ Topographic Map ☐ Online Mapper: Google Earth						
'   ^'	Well v	water wasN/A	ft.		io mapper					
SW SE	after. N/A hour	s pumping N/A	gpm	( F)	n: 1136 ft.	<b>-</b> 0 . 11	1 T TOC			
	Estimated Yield:N/	Agpm								
S	Bore Hole Diameter:	8.25 in. to 35	ft. and	Source: L	Land Survey ☐ C Other .Google.Ea	orth ⊔ 10po	grapine Map			
mile		.N/A in. to N/A	ft.		Other .www.nam	ДИ				
7 WELL WATER TO				10						
1. Domestic:		ater Supply: well ID			ield Water Supply: le					
☐ Household ☐ Lawn & Garden	6. Dewaterir	ng: how many wells?	••••••		e: well ID i □ Uncased □ C		•			
Livestock	7. ☐ Aquiler K	echarge: well ID	W-10		nal: how many bores					
2. Irrigation	9 Environment	al Remediation: well	ID		d Loop  Horizont					
3. ☐ Feedlot	☐ Air Sparg				Loop Surface Dis					
4. Industrial	☐ Recovery				(specify):					
Was a chemical/bacter	iological sample subr	nitted to KDHE?	l Ves ■ No	If yes date sa	mple was submitted	d:				
Water well disinfected?	□ Ves ■ No			•	•					
8 TYPE OF CASING	USED: □ Steel ■ PV	C  Other	CASI	IG IOINTS: I	☐ Glued ☐ Clamped	☐ Welded	Threaded			
Casing diameter 2	8 TYPE OF CASING USED: Steel PVC Other									
Casing height above land	Casing height above land surface 0 in. Weight N/A lbs./ft. Wall thickness or gauge No. Sch. 40									
TYPE OF SCREEN OR										
	nless Steel			☐ Other	(Specify)					
☐ Brass ☐ Galv										
SCREEN OR PERFOR	SCREEN OR PERFORATION OPENINGS ARE:									
☐ Continuous Slot										
☐ Louvered Shutter	☐ Louvered Shutter ☐ Key Punched ☐ Wire Wrapped ☐ Saw Cut ☐ None (Open Hole)									
SCREEN-PERFORATI	SCREEN-PERFORATED INTERVALS: From .20 ft. to .35 ft., From .N/A ft. to .N/A ft., From .N/A ft. to .N/A									
GRAVEL PAG	CK INTERVALS: From	m!O ft. to3	2 ft., From .	!\\/A ft. to	.!\/A ft., From!	₩/ ft. to	!!!/::: ft.			
9 GROUT MATERIA	L: Neat cement	Cement grout	Bentonite (	ther Gravei U	N/A a N/A					
Grout Intervals: From		ft., From!N(A	ft. to <b>N</b> (A)	ft., From	!!!/:: ft. to!!!/:	п.				
Nearest source of possibl  Septic Tank	e contamination:	es Pit Privy	_	Livestock Pens	□ Incoctic	ide Storage				
Sewer Lines	☐ Cess Pool	Sewage I	_	Fuel Storage		oned Water We	-11			
☐ Watertight Sewer Lin				Fertilizer Storag		II/Gas Well	<b></b>			
☐ Other (Specify)		— ·								
Direction from well? . No	rthwest	Distance from	well? .247		ft.					
10 FROM TO	LITHOLO	GIC LOG	FROM	TO LI	THO. LOG (cont.) or	PLUGGING I	INTERVALS			
	(Attached)									
			Notes:							
11 CONTRACTOR'S	OR LANDOWNER	S CERTIFICATIO	N: This water	r well was	constructed, 🔲 reco	onstructed, or	plugged			
under my jurisdiction a	nd was completed on ()	.6/.10/. (mo-day-year	201.9 and	this record is	rule to the loest of m	y knowledge	and belief.			
Kansas Water Well Con	ntractor's License No.	.(고형 This V	Vater Well Reg	cord was comp	neted on mo-day-x	ear) .5/30/20	D.S			
under the business nam	e of KAZEK ENVIOR ong with a fee of \$5.00 for ea	ob constructed well to: V	onese Dans	gnature /	vironment Bureau of 10	out Curre ea	tion			
1000 SW Jackson S	t., Suite 420, Topeka, Kansa	s 66612-1367 Mail and	to Water Well Our	ner and retain one	for your records Telenh	ione 785-296-55	24.			
	s aculustaruellinder himl	S COULD-1301. WIAH OHE I	Water Wen Ow	112	and your records. Telept	Revised 7	/10/2015			

					Braun Project B1709587.03					BORING: MW-10						
KDHE Project Code: U4-066-00496 Seneca Coop 304 Main Street Seneca, Kansas						LOCATION: Lat: 39.83348 Long: 96.05968 GEOLOGIST: David Ross Wells constructed of 2" PVC inside of an 8.25" drilled borehole										
DRILLER: Tony Poulter		ter	METHOD: Hollow Stem Auger		DATE:	6/10/19			SCA	1" = 5'						
Elev. feet 1132.8	et feet ASTM Description of Materials				BPF	WL	PID ppm	Well	Tes	ts or Notes						
1131.8	1.0	L	71.18	Topsoil, dark brown, silty loam						M N		Screening med with a				
- - 1126.8	6.0	CH		CLAY (CH), brown, plastic, moist, soft  CLAY (CH), red brown, plastic, moist, s	soft -	_			0.0		MiniR	AE 3000 Monitor				
-  -									0.0							
1119.8	13.0	CL- ML		CLAY with SITL(CH-ML), brown, very r plasticity	noist, so	ft, low			0.0		·					
- 1113.8 	19.0	SW		SAND (SW), brown, fine to medium grawell sorted, sub rounded	ain, very	moist,			0.0							
1106.8	26.0		740	@ 25' saturated		_		<u>▼</u>	0.0		I	= 24.09' Bo				
-		SC- SM		CLAYEY SAND (SC-SM), brown soft, s	aturated	_										
1097.8	35.0			End of boring Well head completed with a 2' x 2' consteel well vault Top of Case Elevation - 1132.79' amsl Rim Elevation - 1133.10' amsl	crete pad	and 8" —										



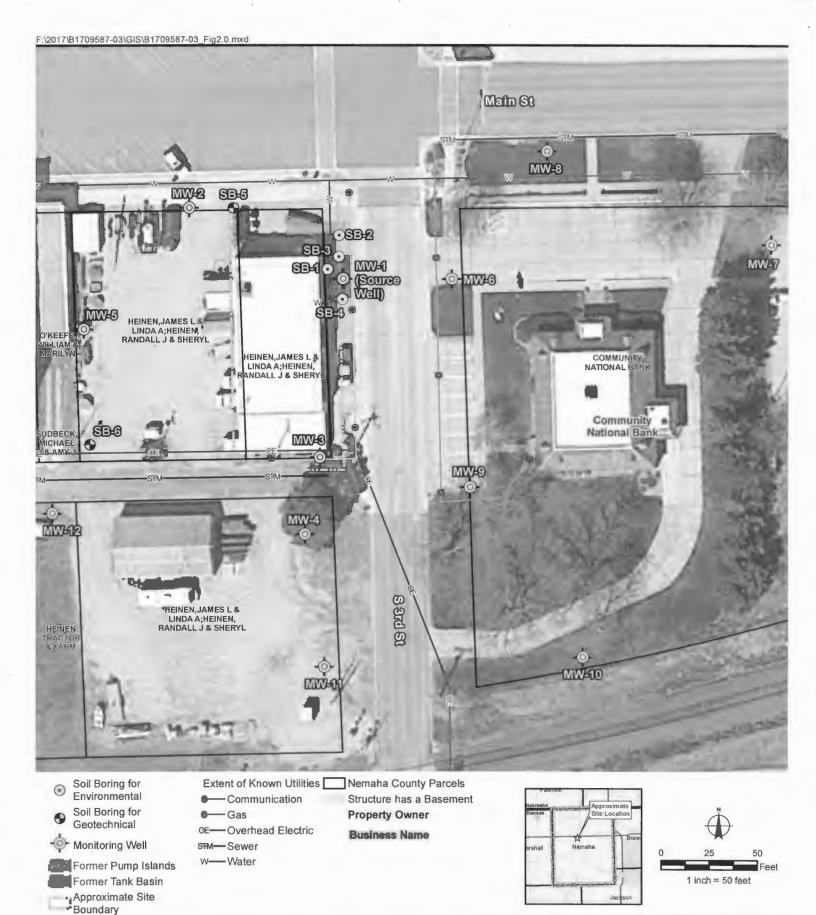

1607 SW 41st Topeka, KS 66609 785.414.7180 braunintertec.com Project No: B1709587.03

Drawing No: B1709587-03\_Fig2.0

 Drawn By:
 CMF

 Date Drawn:
 10/4/2018

 Checked By:
 DR

 Last Modified:
 7/16/2019

Seneca Coop

KDHE Project Code # U4-066-00496

304 Main Street, Seneca, Kansas

Area Base Map

Figure 2.0