
WATER WELL R		orm WW(vision of Water		MW-11					
Original Record		Change in W			ources App. No		Well ID					
1 LOCATION OF W	ATER WELL:	Fract	tion 4 NW ¼ NW ½		Section Number Township Number Range Numb							
County: Nemaha					SE ¼ 34 T 2 S R 12 ■ E □ W Street or Rural Address where well is located (if unknown, distance and							
2 WELL OWNER: L. Business: Seneca C		First:					er's address, check here:					
Address: 304 Main	•					iorseonomy. It as a visit						
Address:		VC		304 Main Street Seneca, KS 66538								
City: Seneca	State	E: KS ZIP:	66538	Seneca, K								
3 LOCATE WELL WITH "X" IN	4 DEPTH OF	COMPLE	TED WELL:	35 f	t. 5 Latitud	e:39.8334	48 (decimal degree					
SECTION BOX:	Depth(s) Ground				Longite	ıde:96.06	015 (decimal degree					
N			A ft., or 4)									
	WELL'S STAT below land											
NW NE	above land					☐ Yes ☐ No) raphic Map						
1 1	Pump test data:	Well water w	as N/A	ft.	☐ Lar							
W ⊀ E	afterN/A	hours pump	ing N/A asN/A	gpm	Online Mapper: Google Earth							
SW SE	after N/A	Well water w	asN.A ing N/A	tt.								
	Estimated Yield	N/A onr	ng	gpm	6 Elevation: 1134ft. ■ Ground Level □ TOC							
S	Bore Hole Dian	neter:Q4.Q	. in. to	ft. and	Source:	☐ Land Survey ☐	GPS Topographic M					
1 mile		N/A	. in. to N/A	ft.		Other GOOGLE.	arth					
7 WELL WATER TO												
1. Domestic:			oply: well ID				lease					
☐ Household ☐ Lawn & Garden	6. ∐ De	watering: nov	w many wells?.	•••••		ole: well IDed □ Uncased □						
Livestock	7. □ Aq 8. ■ Mo	onitoring: wel	e: well ID l ID	W-11	12. Geothe	rmal: how many bore						
2. Irrigation			ediation: well		a) Clos	sed Loop Horizon	ntal 🗌 Vertical					
3. ☐ Feedlot	☐ Ai	r Sparge	☐ Soil Vapor	Extraction			ischarge Inj. of Water					
4. Industrial		covery	☐ Injection									
		e submitted	to KDHE?	Yes No	If yes, date	sample was submitt	ed:					
Water well disinfected?	Yes No											
8 TYPE OF CASING	USED: ☐ Steel	PVC 🗆	Other	CAS	ING JOINTS:	☐ Glued ☐ Clampe	d ☐ Welded ■ Threade					
Casing diameter	NG USED: ☐ Steel ☐ PVC ☐ Other											
TVDE OF SCREEN OF	SUFFACE	III. V	veignt	/ 10s./1t.	wan unckn	ess or gauge Noww	W. 114					
		TION MATERIAL: □ Fiberglass ■ PVC □ Other (Specify)										
		RATION MATERIAL: ☐ Fiberglass ☐ PVC ☐ Other (Specify)										
SCREEN OR PERFOR	ATION OPENI	NGS ARE:		■ PVC □ Other (Specify) □ None used (open hole) Drilled Holes □ Other (Specify)								
☐ Continuous Slot	Mill Slot	NINGS ARE: Gauze Wrapped Torch Cut Drilled Holes Other (Specify)										
Louvered Shutter	ouvered Shutter Key Punched Wire Wrapped Saw Cut None (Open Hole)											
SCREEN-PERFORAT	EEN-PERFORATED INTERVALS: From 20											
O COOLT MATERIA	GRAVEL PACK INTERVALS: From											
Grout Intervals: From	GROUT MATERIAL: ☐ Neat cement ☐ Cement grout ■ Bentonite ■ Other Grayer U.U.2. but Intervals: From											
Nearest source of possib												
☐ Septic Tank	_	ral Lines	☐ Pit Privy		Livestock Pen		ticide Storage					
☐ Sewer Lines ☐ Cess Pool ☐ Sewage Lagoon ☐ Fuel Storage ☐ Abandoned Water Well ☐ Watertight Sewer Lines ☐ Seepage Pit ☐ Feedvard ☐ Fertilizer Storage ☐ Oil Well/Gas Well												
☐ Watertight Sewer Li ☐ Other (Specify)		page Pit	☐ Feedyard	L	Fertilizer Stor	age ∐ Uil w	ell/Gas well					
Direction from well? .No	orth		Distance from	well? 200		1	a.					
10 FROM TO		HOLOGIC L		FROM			or PLUGGING INTERVA					
	(Attached)											
							-					
												
				Notes:								
11 CONTRACTOR	SORIANDOU	NED'S CE	PTIFIC ATIO	N. This was	ter well was	constructed/ [] re-	constructed, or plugg					
under my jurisdiction a	ınd was complete	ed on (mo-da	v-vear) .6/.10/.	2019 an	d this record is	true to the best of	my knowledge and belie					
Kansas Water Well Co	ntractor's Licens	e No759	This V	Vater Well R	ecord was com	pjeted on (mo-¢lay-	year) .6/30/201.9					
under the business name of RAZEK Environmental LLC Signature V. W.) 1.												
Mail 1 white copy along with a fee of \$5.00 for each constructed well to: Kansas Department of Health and Environment, Bureau of Water, GWTS Section, 1000 SW Jackson St., Suite 420, Topeka, Kansas 66612-1367. Mail one to Water Well Owner and retain one for your records. Telephone 785-296-5524.												
Visit us at http://www.kdhel			-1307. IVIAII ONE	to water well U		c for your records. Tele	Revised 7/10/2015					

Ψ÷.

BRAUN" INTERTEC

	n Proje							BORING: MW-11						
KDHE Project Code: U4-066-00496 Seneca Coop 304 Main Street Seneca, Kansas							LOCATION: Lat: 39.83348 Long: 96.06015 GEOLOGIST: David Ross Wells constructed of 2" PVC inside of an 8.25" drilled borehole							
DRILLER: Tony Poulter				METHOD: Hollow Stem Auger			DATE:	6/10/19			SCALE: 1" = 5'			
Elev. feet 1133.4	Depth feet ASTM 0.0 Symbol			Description of Materials (ASTM D2488 or D2487)				BPF	WL	PID ppm				
1132.4	1.0	TS	7.7	Tops	soil, dark bro	wn, silty loam, so	me gravel					M K	Field S	creening
_		СН		CLA	Y (CH), brow	vn, plastic, moist,	soft	-			0.0		MiniRA VOC N	ned with a AE 3000 Monitor
1126.4	7.0	СН		CLA	Y (CH), red b	brown, plastic, m	oist, soft	-			0.0			
1121.4	12.0	CL- ML		CLA plast		CH-ML), brown,	moist, soft, lov				0.0			
1115.4	18.0	SW			D (SW), brow	wn, fine to mediu	m grain, very	moist,		Ā	0.0		SWL =	21.11' BC
-				@ 23	3' saturated			-		Δ	0.0			ted @ 23'
-	20.0							-		,				
1104.4 	29.0	SC- SM		CLA	YEY SAND ((SC-SM), brown	soft, saturated							
1098.4	35.0			Well stee Top	I well vault of Case Elev	eted with a 2' x 2 vation - 1133.39' 1133.63' amsl	-	and 8" -						



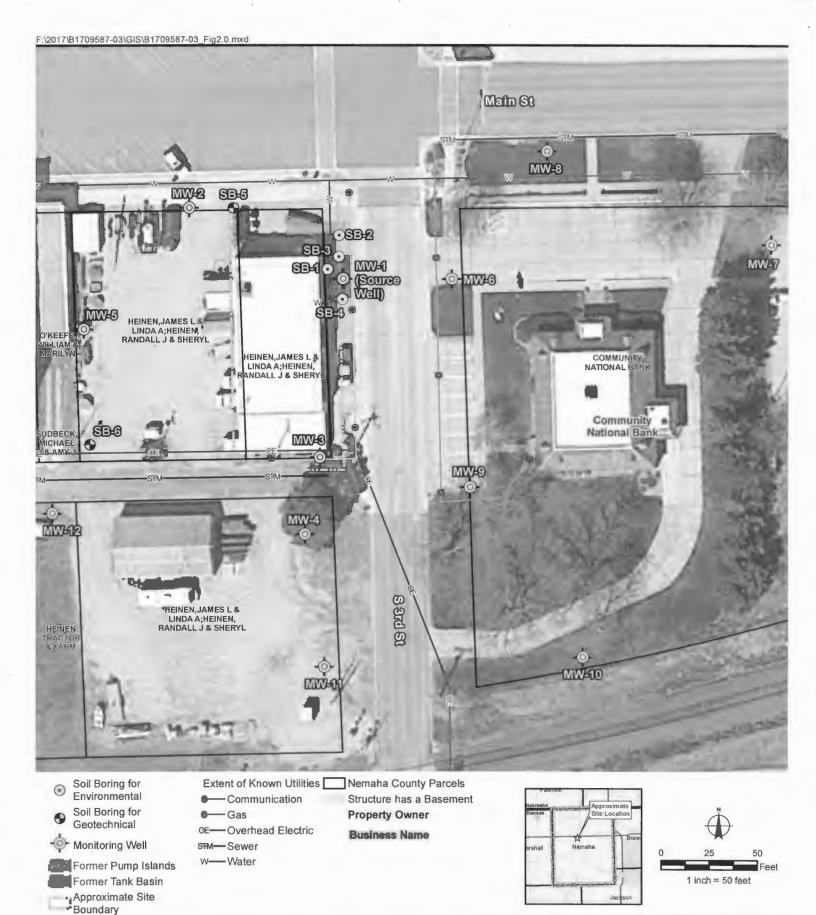

1607 SW 41st Topeka, KS 66609 785.414.7180 braunintertec.com Project No: B1709587.03

Drawing No: B1709587-03_Fig2.0

 Drawn By:
 CMF

 Date Drawn:
 10/4/2018

 Checked By:
 DR

 Last Modified:
 7/16/2019

Seneca Coop

KDHE Project Code # U4-066-00496

304 Main Street, Seneca, Kansas

Area Base Map

Figure 2.0