


1	LOCATION OF WATER WELL:	Fraction	Section Number	Township Number	Range Number
County:	Nemaha	NW ¹ / ₄ NE ¹ / ₄ SW ¹ / ₄	21	2	12 E

Distance and direction from nearest town or city street address of well if located within city?
 1 mile north & 1/2 mile west of Seneca

2 WATER WELL OWNER: Lillis Haverkamp
 RR#, St. Address, Box #: Rt 1 Box 19
 City, State, ZIP Code : Seneca, Ks 66538
 Board of Agriculture, Division of Water Resources
 Application Number:

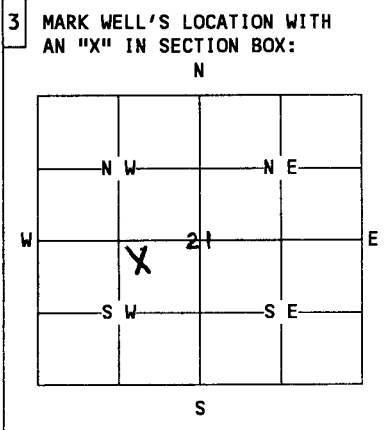

4 DEPTH OF WELL..... 14.....ft.
 WELL'S STATIC WATER LEVEL..... 12.....ft.
 WELL WAS USED AS:
 1 Domestic
 2 Irrigation
 3 Feedlot
 4 Industrial
 5 Public Water Supply
 6 Oil Field Water Supply
 7 Lawn and Garden Only
 8 Air Conditioning
 9 Dewatering
 10 Monitoring Well
 11 Injection Well
 12 Other.....
 Was a chemical/bacteriological sample submitted to Department? Yes....No..X
 If yes, mo/day/yr sample was submitted.....
 Water Well Disinfected: Yes..X.. No.....

5 TYPE OF BLANK CASING USED:
 1 Steel
 2 PVC
 3 RMP (SR)
 4 ABS
 5 Wrought
 6 Asbestos-Cement
 7 Fiberglass
 8 Concrete Tile
 9 Other (specify below) rock
 Blank casing diameter... 40.....in.
 Casing height above or below land surface.....in. 50"
 Was casing pulled? Yes...X.. No..... If yes, how much.....

6 GROUT PLUG MATERIAL: 1 Neat cement 2 Cement grout 3 Bentonite 4 Other.....
 Grout Plug Intervals: From 11..ft. to 12..ft., From.....ft. toft., From..... to.....ft.
 What is the nearest source of possible contamination:
 1 Septic tank
 2 Sewer lines
 3 Watertight sewer lines
 4 Lateral lines
 5 Cess Pool
 6 Seepage pit
 7 Pit privy
 8 Sewage lagoon
 9 Feedyard
 10 Livestock pens
 11 Fuel storage
 12 Fertilizer storage
 13 Insecticide storage
 14 Abandoned water well
 15 Oil well/Gas well
 16 Other (specify below).....
 Direction from well? South east..... How many feet? 1/2 mile.....

FROM	TO	PLUGGING MATERIALS
0	4	bleach
0	11	gravel
11	12	Bentonite
12	14	topsoil

7 CONTRACTOR'S OR LANDOWNER'S CERTIFICATION: This water well was plugged under my jurisdiction and was completed on (mo/day/year) 2/20/95 and this record is true to the best of my knowledge and belief. Kansas Water Well Contractor's License No. This Water Well Record was completed on (mo/day/year) 2/20/95 under the business name of Lillis Haverkamp by (signature) Lillis L. Haverkamp / Darlene H. Haverkamp

INSTRUCTIONS: Use typewriter or ball point pen. Please press firmly and print clearly. Please fill in blanks, underline or circle the correct answers. Send top three copies to Kansas Department of Health and Environment, Bureau of Water, Topeka, Kansas 66620-0001. Telephone: 913/296-3565. Send one to Water Well Owner and retain one for your records.