

9b

USE TYPEWRITER OR BALL POINT PEN-PRESS FIRMLY, PRINT CLEARLY.

ABA
WATER WELL RECORD
KSA 82a-1201-1215


T R EW sec 1/4 1/4 1/4 No.

Kansas State Dept. Of Health
(Water Well Contractors)
Forbes-Bldg. 740
Topeka, Kansas 66620

NEMANA

1 Location of well: County Nemaha Township name Gilman Fraction W 1/2 NE 1/4 Section number 36 Town number 2 Range number 13

Distance and direction from nearest town or city: 5 1/2 East Seneca, Kansas
Street address of well location if in city: _____
3 Owner of well: Nemaha County Sanitary Landfill
Address: Seneca, Kansas

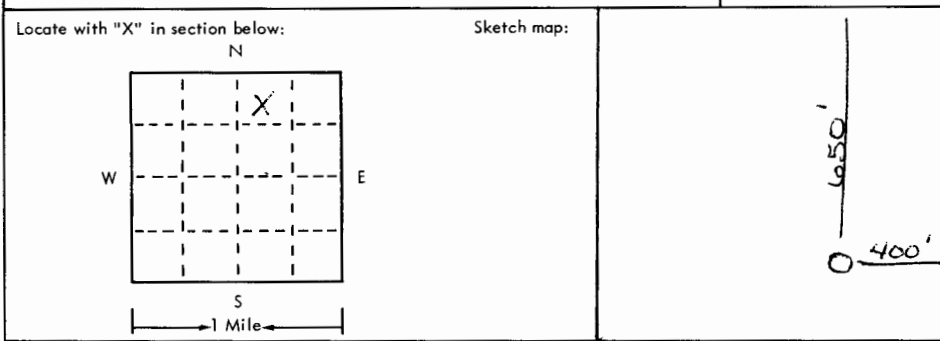

4 Well depth: 60' ft. Date of completion 5/9/75
Well diameter 6" in.
5 Cable tool Rotary Driven Dug
 Hollow rod Jetted Bored Reverse rotary
6 Use: Domestic Public supply Industry
 Irrigation Air conditioning Commercial
 Test well Pizz well
7 Casing: Material PVC Height: above/below
Threaded Welded Surface 33 in.
Diam. _____ Weight 1.52 lbs./ft. _____
4 in. to 60 ft. depth Drive shoe? Yes No
_____ in. to _____ ft. depth

2	Type and color of material	From	To
	<u>Well No 2</u>		
	<u>Top Soil</u>	<u>0</u>	<u>1</u>
	<u>Yellow Sandy Clay</u>	<u>1</u>	<u>11</u>
	<u>Gray Sandy Clay</u>	<u>11</u>	<u>30</u>
	<u>Yellow Sandy Clay</u>	<u>30</u>	<u>37</u>
	<u>Gray Sandy Clay</u>	<u>37</u>	<u>45</u>
	<u>Yellow Sandy Clay</u>	<u>45</u>	<u>52</u>
	<u>Gray Sandy Clay</u>	<u>52</u>	<u>56</u>
	<u>Blue Clay</u>	<u>56</u>	<u>60</u>

8 Screen: Manufacturer Contamined
Type PVC Dia. 4"
Slot/groove .080 Length 20
Set between 40 ft. and 60 ft. _____
Fittings: Gravel pack Yes No Size range of material 1/4 x 1/8

9 Static water level: 6' ft. below land surface Date 5/13/75
10 Pumping level below land surfaces: N.A.
_____ ft. after _____ hrs. pumping _____ g.p.m.
_____ ft. after _____ hrs. pumping _____ g.p.m.
Estimated maximum yield _____ g.p.m.

11 Water sample submitted: Yes No Date _____

12 Well head completion: Capped
 Pitless adapter Inches above grade

13 Well grouted? Yes No
 Neat cement Bentonite _____
Depth: From 0 ft. to 102 ft.

14 Nearest source of possible contamination: ft. 2000 Direction _____ Type Barnyard
Well disinfected upon completion? Yes No

15 Pump: Not installed
Manufacturer's name _____
Model number _____ HP _____ Volts _____
Length of drop pipe _____ ft. capacity _____ g.m.p.
Type: Submersible Turbine
 Jet Reciprocating
 Centrifugal Other

16 Remarks: elevation _____
Topography: Hill Slope Upland Valley

17 Water well contractor's certification:
This well was drilled under my jurisdiction and this report is true to the best of my knowledge and belief.
Strader Drilling Co, Inc 182
Business name License No. _____
Address Rt 1 Holton, Kansas
Signed Daryl Johnson Date 6-3-75
Authorized representative