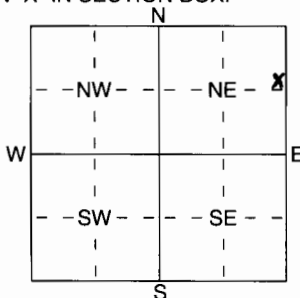


1 LOCATION OF WATER WELL:	Fraction	Section Number	Township Number	Range Number
County: <u>Neoga</u>	<u>SE 1/4 SE 1/4 NE 1/4</u>	<u>12</u>	T <u>2</u> S	R <u>13</u> EW

Distance and direction from nearest town or city street address of well if located within city?

5 mi. west, 1/4 mi. south from Sabetha, KS.2 WATER WELL OWNER: Richard KidwellRR#, St. Address, Box # : 2481 168th Rd.
City, State, ZIP Code : Sabetha, KS, 66534Board of Agriculture, Division of Water Resources
Application Number:

3 LOCATE WELL'S LOCATION WITH AN "X" IN SECTION BOX:

4 DEPTH OF COMPLETED WELL 132 ft. ELEVATION:

Depth(s) Groundwater Encountered 1 31 ft. 2 78 ft. 3 120 ft.
 WELL'S STATIC WATER LEVEL 98 ft. below land surface measured on mo/day/yr 7-6-06
 Pump test data: Well water was _____ ft. after _____ hours pumping _____ gpm
 Est. Yield 12 gpm: Well water was _____ ft. after _____ hours pumping _____ gpm
 WELL WATER TO BE USED AS: 5 Public water supply 8 Air conditioning 11 Injection well
 1 Domestic 3 Feedlot 6 Oil field water supply 9 Dewatering 12 Other (Specify below)
 2 Irrigation 4 Industrial 7 Domestic (lawn & garden) 10 Monitoring well

Was a chemical/bacteriological sample submitted to Department? Yes _____ No X _____; If yes, mo/day/yr sample was submitted
Water Well Disinfected? Yes _____ No X

5 TYPE OF BLANK CASING USED:

1 Steel
2 PVC
3 RMP (SR)
4 ABS5 Wrought iron
6 Asbestos-Cement
7 Fiberglass
8 Concrete tile
9 Other (specify below)CASING JOINTS: Glued X Clamped _____
Welded _____
Threaded _____Blank casing diameter 5 in. to 1.17 ft. Dia 5 in. X 1.30 - 1.38 ft. Dia _____ in. to _____ ft.Casing height above land surface 20 in., weight _____ lbs./ft. Wall thickness or guage No. 50821

TYPE OF SCREEN OR PERFORATION MATERIAL:

1 Steel
2 Brass
3 Stainless Steel
4 Galvanized Steel5 Fiberglass
6 Concrete tile
7 PVC
8 RMP (SR)
9 ABS10 Asbestos-Cement
11 Other (Specify) _____
12 None used (open hole)

SCREEN OR PERFORATION OPENINGS ARE:

1 Continuous slot
2 Louvered shutter
3 Mill slot
4 Key punched5 Guazed wrapped
6 Wire wrapped
7 Torch cut8 Saw cut
9 Drilled holes
10 Other (specify) _____ ft.
11 None (open hole)SCREEN-PERFORATED INTERVALS: From 1.17 ft. to 1.30 ft., From _____ ft. to _____ ft.

From _____ ft. to _____ ft., From _____ ft. to _____ ft.

GRAVEL PACK INTERVALS: From 25 ft. to 1.38 ft., From _____ ft. to _____ ft.

From _____ ft. to _____ ft., From _____ ft. to _____ ft.

6 GROUT MATERIAL:

1 Neat cement

2 Cement grout

3 Bentonite

4 Other _____

Grout Intervals: From 8 ft. to 25 ft., From _____ ft. to _____ ft., From _____ ft. to _____ ft.

What is the nearest source of possible contamination:

1 Septic tank
2 Sewer lines
3 Watertight sewer lines
4 Lateral lines
5 Cess pool
6 Seepage pit7 Pit privy
8 Sewage lagoon
9 Feedyard10 Livestock pens
11 Fuel storage
12 Fertilizer storage
13 Insecticide storage
14 Abandoned water well
15 Oil well/Gas well
16 Other (specify below)
none known

Direction from well?

How many feet?

FROM	TO	LITHOLOGIC LOG	FROM	TO	PLUGGING INTERVALS
0	2	Topsoil - brown			
2	6	clay - tan			
6	64	Sand, gravel, clay - yellow/tan			
64	73	Sand, gravel, clay - light olive			
73	78	clay - red to gray, gravel - yellow			
78	81	clay - red to gray, gravel - some large cobbles - yellow/tan			
81	89	clay, gravel - yellow/tan - small			
89	96	gravel (up to 1") some clay - light olive			
96	108	clay with some gravel (up to 3/4") - light gray			
108	111	sand, gravel, clay, some limestone - light tan			
111	115	Shale with some sand, gravel (up to 3/4") - gray			
115	120	gravel (up to 4"), sand, clay - tan to gray			
120	126	Shale (loose), gravel (1/2 to 1/4") - gray			
126	138	Shale - gray			

7 CONTRACTOR'S OR LANDOWNER'S CERTIFICATION: This water well was (1) constructed, (2) reconstructed, or (3) plugged under my jurisdiction and was completed on (mo/day/year) 7-6-06 and this record is true to the best of my knowledge and belief. Kansas Water Well Contractor's Licence No 22 This Water Well Record was completed on (mo/day/yr) 7-12-06 under the business name of Meyer Well Drilling by (signature) Steven E. Meyer