9-24-71

SE TYPEWRITER OR BALL OINT PEN-PRESS FIRMLY, RINT CLEARLY.

WATER WELL RECORD
KSA 82a-1201-1215

Kansas Department of Health and Environment-Division of Environment
(Water well Contractors)
Topeka, Kansas 66620

1. Location of well:	County	Fraction	Section number	Township number	Range number
	Nemaha	NE 1/4 NE 1/4 NE 1/4	3	T 2 (S)	R 13 (E) W

2. Distance and direction from nearest town or city: 3N .3 E
Street address of well location if in city: of ONeida

3. Owner of well: Nemaha RWD #1
R.R. or street:
City, state, zip code: BeRN, Ks.
#2 well

4. Locate with "X" in section below:

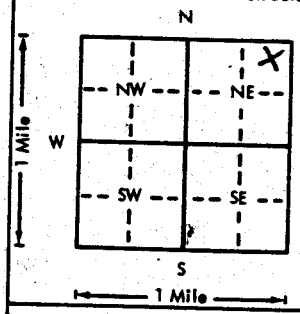

Sketch map:

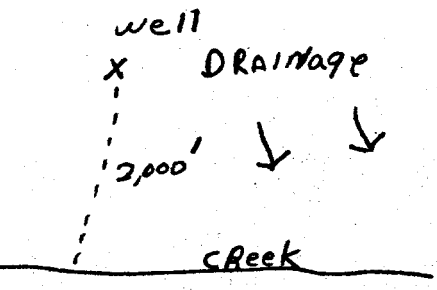

6. Bore hole dia. 18 in. Completion date
Well depth 43 ft. 10-3-77

7. __ Cable tool ✓ Rotary __ Driven __ Dug
__ Hollow rod __ Jetted __ Bored __ Reverse rotary

8. Use: __ Domestic ✓ Public supply __ Industry
__ Irrigation __ Air conditioning __ Stock
__ Lawn __ Oil field water __ Other

9. Casing: Material STeel Height: Above or below
Threaded ___ Welded ✓ Surface 36 in.
RMP ___ PVC ___ Weight 19 lbs./ft.
Dia. 6 in. to 33 ft. depth Well Thickness: inches or
Dia. ___ in. to ___ ft. depth gage No. .280

10. Screen: Manufacturer's name JOHNSON
Type STAINLESS Dia. 6
Slot gauze .080 Length 5
Set between 33 ft. and 38 ft.
ft. and ft.
Gravel pack? ✓ Size range of material 1/4 X 1/8

11. Static water level: mo./day/yr.
10 ft. below land surface Date 10-3-77

12. Pumping level below land surfaces:
ft. after hrs. pumping g.p.m.
ft. after hrs. pumping g.p.m.
Estimated maximum yield 80 g.p.m.

13. Water sample submitted: mo./day/yr.
Yes ✓ No Date

14. Well head completion:
✓ Pitless adapter 18 Inches above grade

15. Well grouted? ✓
With: ✓ Neat cement ___ Bentonite ___ Concrete
Depth: From 0 ft. to 20 ft.

16. Nearest source of possible contamination:
ft. 2,000 Direction S Type DRAINAGE
Well disinfected upon completion? ✓ Yes ___ No

17. Pump: ___ Not installed
Manufacturer's name JACUZZI
Model number 7556A15 HP 7.5 Volts 230
Length of drop pipe 30 ft. capacity 55 g.p.m.
Type:
✓ Submersible ___ Turbine
___ Jet ___ Reciprocating
___ Centrifugal ___ Other

5. Type and color of material

		From	To
TOP SOIL		0	3
Clay, BROWN	01	3	30
Fine Sand, Course Sand	05	30	31
Fine Sand, Course Sand, Pea gRAvel	17	31	38
Shale, gRey	19	38	43

(Use a second sheet if needed)

17
01

18. Elevation: 1215
Topography:
___ Hill
___ Slope
___ Upland
✓ Valley

19. Remarks:
GROVE + CO. Engineering
MARYSVILLE, Ks.

RECEIVED 20 OCT 1977 DIVISION OF ENVIRONMENT

20. Water well contractor's certification:
This well was drilled under my jurisdiction and this report is true to the best of my knowledge and belief.
TRADER DRLG CO INC 182
Business name License No.
Address HOLTON, KS
Signed Dale Cochran Date 10-10-77
Authorized representative

Forward the white, blue and pink copies to the Department of Health and Environment

Form WWC-5

T 2 S R 13 E Sec 3 NE NE NE 1/4 1/4 1/4