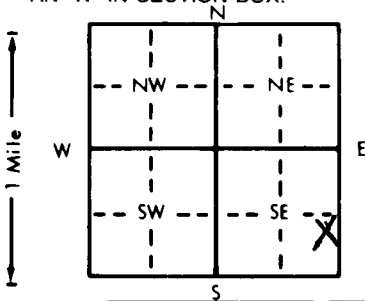


1 LOCATION OF WATER WELL: County: Nemaha Fraction: NE 1/4 SE 1/4 SE 1/4 Section Number: 1 Township Number: T 2 S Range Number: R 14 E/W

Distance and direction from nearest town or city street address of well if located within city?
1059 Hwy 75, Sabetha, Ks

2 WATER WELL OWNER: Casey's General Store, Inc. Board of Agriculture, Division of Water Resources
 RR#, St. Address, Box #: One Convenience Blvd Application Number:
 City, State, ZIP Code: Ankerly, IA 50021 MW# 2

3 LOCATE WELL'S LOCATION WITH AN "X" IN SECTION BOX:

 4 DEPTH OF COMPLETED WELL: 20 ft. ELEVATION:
 Depth(s) Groundwater Encountered 1. 1 ft. 2. 5.47 ft. 3. 5.47 ft.
 WELL'S STATIC WATER LEVEL 5.47 ft. below land surface measured on mo/day/yr
 Pump test data: Well water was 6 ft. after 20 hours pumping 20 gpm
 Est. Yield 6 gpm: Well water was 20 ft. after 20 hours pumping 20 gpm
 Bore Hole Diameter 6 in. to 20 ft., and 20 in. to 20 ft.
 WELL WATER TO BE USED AS:
 5 Public water supply 8 Air conditioning 11 Injection well
 1 Domestic 3 Feedlot 6 Oil field water supply 9 Dewatering 12 Other (Specify below)
 2 Irrigation 4 Industrial 7 Lawn and garden only 10 Monitoring well
 Was a chemical/bacteriological sample submitted to Department? Yes X No X; If yes, mo/day/yr sample was submitted
 Water Well Disinfected? Yes X No X

5 TYPE OF BLANK CASING USED:
 1 Steel 3 RMP (SR) 5 Wrought iron 8 Concrete tile CASING JOINTS: Glued X Clamped X
 2 PVC 4 ABS 6 Asbestos-Cement 9 Other (specify below) Welded X
 7 Fiberglass Threaded X
 Blank casing diameter 2 in. to 5 ft., Dia. 0.716 in. to 1.54 ft., Dia. 0.154 in. to 1.54 ft.
 Casing height above land surface 0.5 in., weight 0.716 lbs./ft. Wall thickness or gauge No. 0.154
 TYPE OF SCREEN OR PERFORATION MATERIAL:
 1 Steel 3 Stainless steel 5 Fiberglass 8 RMP (SR) 10 Asbestos-cement
 2 Brass 4 Galvanized steel 6 Concrete tile 9 ABS 11 Other (specify) 7 PVC
 12 None used (open hole)
 SCREEN OR PERFORATION OPENINGS ARE:
 1 Continuous slot 3 Mill slot 5 Gauzed wrapped 8 Saw cut 11 None (open hole)
 2 Louvered shutter 4 Key punched 6 Wire wrapped 9 Drilled holes
 7 Torch cut 10 Other (specify) 5
 SCREEN-PERFORATED INTERVALS: From 0 ft. to 20 ft., From 0 ft. to 20 ft.
 GRAVEL PACK INTERVALS: From 4 ft. to 20 ft., From 4 ft. to 20 ft.

6 GROUT MATERIAL: 1 Neat cement 2 Cement grout 3 Bentonite 4 Other
 Grout Intervals: From 0 ft. to 1 ft., From 1 ft. to 4 ft., From 4 ft. to 4 ft.
 What is the nearest source of possible contamination:
 1 Septic tank 4 Lateral lines 7 Pit privy 10 Livestock pens 14 Abandoned water well
 2 Sewer lines 5 Cess pool 8 Sewage lagoon 11 Fuel storage 15 Oil well/Gas well
 3 Watertight sewer lines 6 Seepage pit 9 Feedyard 12 Fertilizer storage 16 Other (specify below) Contaminated site
 13 Insecticide storage

Direction from well?

FROM	TO	LITHOLOGIC LOG	FROM	TO	PLUGGING INTERVALS
0	1	Surface			
1	25	Clay			

7 CONTRACTOR'S OR LANDOWNER'S CERTIFICATION: This water well was (1) constructed, (2) reconstructed, or (3) plugged under my jurisdiction and was completed on (mo/day/year) 7-23-97 and this record is true to the best of my knowledge and belief. Kansas Water Well Contractor's License No. 554 This Water Well Record was completed on (mo/day/yr) 9-11-97 under the business name of AGD Services, Inc. by signature Jay C. Woofers