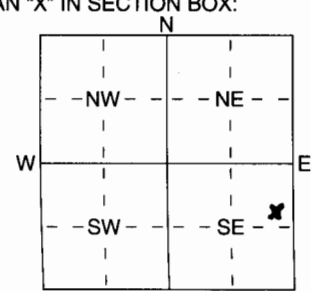


1 LOCATION OF WATER WELL: Fraction SE 1/4 NE 1/4 SE 1/4 Section Number 15 Township Number T 2 S Range Number R 14 E/W
 County: Nemaha

Distance and direction from nearest town or city street address of well if located within city?
1 mi. west, 1 1/2 mi. south from Sabetha, Ks.

2 WATER WELL OWNER: Dennis Studer
 RR#, St. Address, Box #: Rt. 4 Box 204 Board of Agriculture, Division of Water Resources
 City, State, ZIP Code: Sabetha, Ks. 66534 Application Number:

3 LOCATE WELL'S LOCATION WITH AN "X" IN SECTION BOX:  4 DEPTH OF COMPLETED WELL 133 1/2 ft. ELEVATION:
 Depth(s) Groundwater Encountered 1 31 ft. 2 70 ft. 3 122 ft.
 WELL'S STATIC WATER LEVEL 73 ft. below land surface measured on mo/day/yr 7-20-05
 Pump test data: Well water was ft. after hours pumping gpm
 Est. Yield 30.1 gpm: Well water was ft. after hours pumping gpm
 WELL WATER TO BE USED AS: 5 Public water supply 8 Air conditioning 11 Injection well
 Domestic 3 Feedlot 6 Oil field water supply 9 Dewatering 12 Other (Specify below)
 2 Irrigation 4 Industrial 7 Domestic (lawn & garden) 10 Monitoring well
 Was a chemical/bacteriological sample submitted to Department? Yes No ; If yes, mo/day/yr sample was submitted
 Water Well Disinfected? Yes No

5 TYPE OF BLANK CASING USED: 5 Wrought iron 8 Concrete tile CASING JOINTS: Glued Clamped
 1 Steel 3 RMP (SR) 6 Asbestos-Cement 9 Other (specify below) Welded
 PVC 4 ABS 7 Fiberglass Threaded
 Blank casing diameter 5 in. to 113 1/2 ft., Dia in. to ft., Dia in. to ft.
 Casing height above land surface 1.8 in., weight lbs./ft. Wall thickness or guage No. SDR 21
 TYPE OF SCREEN OR PERFORATION MATERIAL: PVC 10 Asbestos-Cement
 1 Steel 3 Stainless Steel 5 Fiberglass 8 RMP (SR) 11 Other (Specify)
 2 Brass 4 Galvanized Steel 6 Concrete tile 9 ABS 12 None used (open hole)
 SCREEN OR PERFORATION OPENINGS ARE: 5 Gauzed wrapped 8 Saw cut 11 None (open hole)
 1 Continuous slot Mill slot .030" 6 Wire wrapped 9 Drilled holes
 2 Louvered shutter 4 Key punched 7 Torch cut 10 Other (specify) ft.
 SCREEN-PERFORATED INTERVALS: From 113 1/2 ft. to 133 1/2 ft., From ft. to ft.
 GRAVEL PACK INTERVALS: From 22 ft. to 133 1/2 ft., From ft. to ft.

6 GROUT MATERIAL: 1 Neat cement 2 Cement grout Bentonite 4 Other
 Grout Intervals: From 4 ft. to 22 ft., From ft. to ft., From ft. to ft.
 What is the nearest source of possible contamination: 10 Livestock pens 14 Abandoned water well
 1 Septic tank 4 Lateral lines 7 Pit privy 11 Fuel storage 15 Oil well/Gas well
 2 Sewer lines 5 Cess pool 8 Sewage lagoon 12 Fertilizer storage 16 Other (specify below)
 3 Watertight sewer lines 6 Seepage pit 9 Feedyard 13 Insecticide storage
 Direction from well? How many feet?

FROM	TO	LITHOLOGIC LOG	FROM	TO	PLUGGING INTERVALS
0	3	Topsoil - black			
3	30	Sandy clay - yellow			
30	38	Fine sand - yellow - unstable			
38	45	Sandy clay - olive to gray			
45	58	Sandy clay - gray			
58	71	Sandy, gravelly clay - gray			
71	74	Sand, some clay - olive to gray			
74	85	Gravelly clay - gray			
85	95	clay, some gravel - Lt. green			
95	122	Rocky, gravelly clay - gray			
122	126	chert - gray - extremely hard			
126	133 1/2	Shale - gray to olive			

7 CONTRACTOR'S OR LANDOWNER'S CERTIFICATION: This water well was constructed, (2) reconstructed, or (3) plugged under my jurisdiction and was completed on (mo/day/year) 7-20-05 and this record is true to the best of my knowledge and belief. Kansas Water Well Contractor's Licence No 627 This Water Well Record was completed on (mo/day/yr) 7-22-05 under the business name of Meyer Well Drilling by (signature) Steven E. Meyer