


1 LOCATION OF WATER WELL: County: Neomaha Fraction: NW 1/4 SE 1/4 SW 1/4 Section Number: 1 Township Number: T 2 S Range Number: R 14 E

Distance and direction from nearest town or city street address of well if located within city?
121 S 8th

2 WATER WELL OWNER: Agee's Service, Inc. Board of Agriculture, Division of Water Resources
 RR#, St. Address, Box #: 121 S 8th Application Number:
 City, State, ZIP Code: Sabetha KS 66534

3 LOCATE WELL'S LOCATION WITH AN "X" IN SECTION BOX:

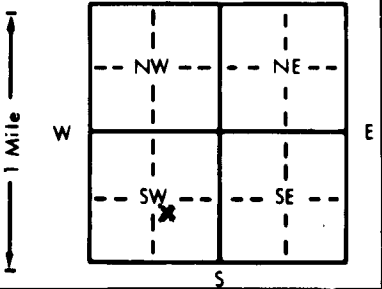

4 DEPTH OF COMPLETED WELL: 13.7 ft. ELEVATION:

Depth(s) Groundwater Encountered 1. ft. 2. ft. 3. ft.
 WELL'S STATIC WATER LEVEL: 1.14 ft. below land surface measured on mo/day/yr 1-14-89
 Pump test data: Well water was ft. after hours pumping gpm
 Est. Yield: 20 gpm: Well water was ft. after hours pumping gpm
 Bore Hole Diameter: 8 in. to 10.7 ft., and 4.7 in. to 13.7 ft.
 WELL WATER TO BE USED AS:
 1 Domestic 3 Feedlot 6 Oil field water supply 9 Dewatering 12 Other (Specify below)
 2 Irrigation 4 Industrial 7 Lawn and garden only 10 Observation well CAR WASH
 Was a chemical/bacteriological sample submitted to Department? Yes.....No X.....; If yes, mo/day/yr sample was submitted
 Water Well Disinfected? Yes X No

5 TYPE OF BLANK CASING USED: 1 Steel 3 RMP (SR) 5 Wrought iron 8 Concrete tile CASING JOINTS: Glued X Clamped
2 PVC 4 ABS 7 Fiberglass 9 Other (specify below) Welded
 Blank casing diameter: 5 in. to 10.7 ft., Dia. 4 in. to 13.7 ft., Dia. in. to ft.
 Casing height above land surface: 2.0 in., weight 2.843 lbs./ft. Wall thickness or gauge No. 200 PSI
 TYPE OF SCREEN OR PERFORATION MATERIAL: 1 Steel 3 Stainless steel 5 Fiberglass 8 RMP (SR) 10 Asbestos-cement
 2 Brass 4 Galvanized steel 6 Concrete tile 9 ABS 11 Other (specify) 12 None used (open hole)
 SCREEN OR PERFORATION OPENINGS ARE: 1 Continuous slot 3 Mill slot 5 Gauzed wrapped 8 Saw cut 11 None (open hole)
 2 Louvered shutter 4 Key punched 6 Wire wrapped 9 Drilled holes
 7 Torch cut 10 Other (specify)

SCREEN-PERFORATED INTERVALS: From 1.27 ft. to 13.7 ft., From ft. to ft.
 GRAVEL PACK INTERVALS: From NONE ft. to ft., From ft. to ft.

6 GROUT MATERIAL: 1 Neat cement 2 Cement grout 3 Bentonite 4 Other
 Grout Intervals: From 0 ft. to 15 ft., From ft. to ft., From ft. to ft.
 What is the nearest source of possible contamination:
 1 Septic tank 4 Lateral lines 7 Pit privy 10 Livestock pens 14 Abandoned water well
 2 Sewer lines 5 Cess pool 8 Sewage lagoon 11 Fuel storage 15 Oil well/Gas well
 3 Watertight sewer lines 6 Seepage pit 9 Feedyard 12 Fertilizer storage 16 Other (specify below)
3 Insecticide storage NONE KNOWN

Direction from well? How many feet?

FROM	TO	LITHOLOGIC LOG	FROM	TO	LITHOLOGIC LOG
0	5	MS	109.2	115	SHALE GRAY
5	13	Silty clay BR	115	116	LS GRAY
13	30	CLAY LG GRAY	116	116.8	SHALE GRAY
30	31	SAND BR VF-F	116.8	117.5	LS GRAY
31	66	SANDY CLAY BR	117.5	119	SHALE LG GRAY
66	67	SAND BR VF-C	119	120	SHALE Red
67	76.5	SANDY CLAY BR	120	123	SHALE greenish GRAY
76.5	78.1	LS GRAY	123	125	SHALE Red
78.1	80	SHALE Bluish GRAY	125	126	SHALE GRAY
80	82	SHALE Olive	126	127.5	SHALE Red
82	93	SHALE Red	127.5	129.5	SHALE GRAY
93	94	LS LG GRAY	129.5	131	SHALE LG GRAY
94	96.5	LS GRAY	131	133	LS LG GRAY Lost c BR
96.5	107	SHALE GRAY	133	137	SHALE LG GRAY?
107	109.2	LS BR			

7 CONTRACTOR'S OR LANDOWNER'S CERTIFICATION: This water well was (1) constructed (2) reconstructed, or (3) plugged under my jurisdiction and was completed on (mo/day/year) 1-14-89 and this record is true to the best of my knowledge and belief. Kansas
 Water Well Contractor's License No. 308 This Water Well Record was completed on (mo/day/yr) 1-14-89
 under the business name of Bieschick Drilling Co by (signature) Ray Bieschick

INSTRUCTIONS: Use typewriter or ball point pen. PLEASE PRESS FIRMLY and PRINT clearly. Please fill in blanks, underline or circle the correct answers. Send top three copies to Kansas Department of Health and Environment, Bureau of Water Protection, Topeka, Kansas 66620-7320. Telephone: 913-862-9360. Send one to WATER WELL OWNER and retain one for your records.