


1 LOCATION OF WATER WELL: Fraction NW 1/4 SE 1/4 NE 1/4 Section Number 1 Township Number T 2 S Range Number R 14E EW
 County: NEMAHA Distance and direction from nearest town or city street address of well if located within city?

1/2 mile north of Sabetha

2 WATER WELL OWNER: City of Sabetha
 RR#, St. Address, Box # : Sabetha, KS Board of Agriculture, Division of Water Resources
 City, State, ZIP Code : Sabetha, KS Application Number:

3 LOCATE WELL'S LOCATION WITH AN "X" IN SECTION BOX:

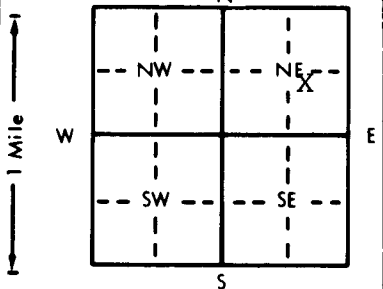

4 DEPTH OF COMPLETED WELL... 100 ft. ELEVATION:

Depth(s) Groundwater Encountered 1... 56' ft. 2... 72' ft. 3... ft.
 WELL'S STATIC WATER LEVEL... 47' ft. below land surface measured on mo/day/yr 1-16-89
 Pump test data: Well water was... ft. after... hours pumping... gpm
 Est. Yield... 30... gpm: Well water was... ft. after... hours pumping... gpm
 Bore Hole Diameter... 10" in. to... ft., and... in. to... ft.
 WELL WATER TO BE USED AS: 5 Public water supply 8 Air conditioning 11 Injection well
 1 Domestic 3 Feedlot 6 Oil field water supply 9 Dewatering 12 Other (Specify below)
 2 Irrigation 4 Industrial 7 Lawn and garden only 10 Monitoring well
 Was a chemical/bacteriological sample submitted to Department? Yes... No...; If yes, mo/day/yr sample was sub-
 mitted Water Well Disinfected? Yes No

5 TYPE OF BLANK CASING USED: 5 Wrought iron 8 Concrete tile CASING JOINTS: Glued Clamped
 1 Steel 3 RMP (SR) 6 Asbestos-Cement 9 Other (specify below) Welded
 2 PVC 4 ABS 7 Fiberglass Threaded

Blank casing diameter... 5" in. to... 0-50... ft., Dia... 5" in. to... 60-66... ft., Dia... 5" in. to... 76-100... ft.
 Casing height above land surface... 24" in., weight... 2.82... lbs./ft. Wall thickness or gauge No... 258.

TYPE OF SCREEN OR PERFORATION MATERIAL: 7 PVC 10 Asbestos-cement
 1 Steel 3 Stainless steel 5 Fiberglass 8 RMP (SR) 11 Other (specify) Johnson .025
 2 Brass 4 Galvanized steel 6 Concrete tile 9 ABS 12 None used (open hole)

SCREEN OR PERFORATION OPENINGS ARE: 5 Gauzed wrapped 8 Saw cut 11 None (open hole)
 1 Continuous slot 3 Mill slot 6 Wire wrapped 9 Drilled holes
 2 Louvered shutter 4 Key punched 7 Torch cut 10 Other (specify)

SCREEN-PERFORATED INTERVALS: From... 50... ft. to... 60... ft., From... ft. to... ft.
 From... 66... ft. to... 76... ft., From... ft. to... ft.
 GRAVEL PACK INTERVALS: From... 30... ft. to... 100... ft., From... ft. to... ft.
 From... ft. to... ft., From... ft. to... ft.

6 GROUT MATERIAL: 1 Neat cement 2 Cement grout 3 Bentonite 4 Other
 Grout Intervals: From... 0... ft. to... 30... ft., From... ft. to... ft., From... ft. to... ft.

What is the nearest source of possible contamination: 10 Livestock pens 14 Abandoned water well
 1 Septic tank 4 Lateral lines 7 Pit privy 11 Fuel storage 15 Oil well/Gas well
 2 Sewer lines 5 Cess pool 8 Sewage lagoon 12 Fertilizer storage 16 Other (specify below)
 3 Watertight sewer lines 6 Seepage pit 9 Feedyard 13 Insecticide storage

Direction from well? W How many feet? 680

FROM	TO	LITHOLOGIC LOG	FROM	TO	PLUGGING INTERVALS
0	14	Clay-Brown			
14	21	Shale-Yellow			
21	47	Shale-Red			
47	51	Limestone-Brown			
51	55	Shale-Grey			
55	56	Limestone-Yellow 10 GPM			
56	68	Shale-Grey			
68	72	Limestone-Brown 20 GPM			
72	74	Shale-Grey			
74	76	Limestone-Grey			
76	100	Shaley Limestone-Grey			

7 CONTRACTOR'S OR LANDOWNER'S CERTIFICATION: This water well was (1) constructed, (2) reconstructed, or (3) plugged under my jurisdiction and was completed on (mo/day/year) 1-16-89 and this record is true to the best of my knowledge and belief. Kansas Water Well Contractor's License No. 182 This Water Well Record was completed on (mo/day/yr) 4-21-89 under the business name of STRADER DRILLING CO., INC. by (signature) [Signature]