


1 LOCATION OF WATER WELL: Fraction NE 1/4 SE 1/4 SE 1/4 Section Number 35 Township Number T 2 S Range Number R 14 EW

Distance and direction from nearest town or city street address of well if located within city?  
 4 1/2 south of Sabetha

2 WATER WELL OWNER: Greg Renyer  
 RR#, St. Address, Box #: Rt. 4 Box 186 Board of Agriculture, Division of Water Resources  
 City, State, ZIP Code: Sabetha, KS 66534 Application Number:

3 LOCATE WELL'S LOCATION WITH AN "X" IN SECTION BOX:

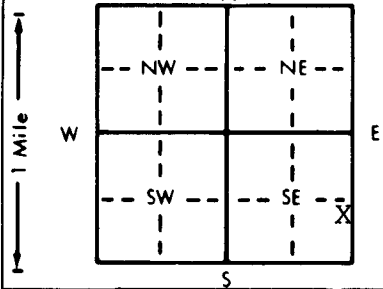

4 DEPTH OF COMPLETED WELL: 160' ft. ELEVATION:  
 Depth(s) Groundwater Encountered 1. 138' ft. 2. ft. 3. ft.  
 WELL'S STATIC WATER LEVEL: 60' ft. below land surface measured on mo/day/yr 11-14-90  
 Pump test data: Well water was ft. after hours pumping gpm  
 Est. Yield: 20 gpm; Well water was ft. after hours pumping gpm  
 Bore Hole Diameter: 8 3/4 in. to ft., and in. to ft.  
 WELL WATER TO BE USED AS:  
 1 Domestic 3 Feedlot 6 Oil field water supply 9 Dewatering 12 Other (Specify below)  
 2 Irrigation 4 Industrial 7 Lawn and garden only 10 Monitoring well  
 Was a chemical/bacteriological sample submitted to Department? Yes No X; If yes, mo/day/yr sample was submitted Water Well Disinfected? Yes X No

5 TYPE OF BLANK CASING USED:  
 1 Steel 3 RMP (SR) 5 Wrought iron 8 Concrete tile CASING JOINTS: Glued X Clamped  
 2 PVC 4 ABS 6 Asbestos-Cement 9 Other (specify below) Welded  
 7 Fiberglass Threaded

Blank casing diameter: 5 in. to 0-100 ft., Dia in. to ft., Dia in. to ft.  
 Casing height above land surface: 24 in., weight 2.82 lbs./ft. Wall thickness or gauge No. 258

TYPE OF SCREEN OR PERFORATION MATERIAL:  
 1 Steel 3 Stainless steel 5 Fiberglass 7 PVC 10 Asbestos-cement  
 2 Brass 4 Galvanized steel 6 Concrete tile 8 RMP (SR) 11 Other (specify)  
 12 None used (open hole)

SCREEN OR PERFORATION OPENINGS ARE:  
 1 Continuous slot 3 Mill slot 5 Gauzed wrapped 8 Saw cut 11 None (open hole)  
 2 Louvered shutter 4 Key punched 6 Wire wrapped 9 Drilled holes  
 7 Torch cut 10 Other (specify)

SCREEN-PERFORATED INTERVALS: From 100 ft. to 160 ft., From ft. to ft. to ft.  
 GRAVEL PACK INTERVALS: From 24 ft. to 160 ft., From ft. to ft. to ft.

6 GROUT MATERIAL: 1 Neat cement 2 Cement grout 3 Bentonite 4 Other hole plug  
 Grout Intervals: From 4 ft. to 24 ft., From ft. to ft. to ft.

What is the nearest source of possible contamination:  
 1 Septic tank 4 Lateral lines 7 Pit privy 10 Livestock pens 14 Abandoned water well  
 2 Sewer lines 5 Cess pool 8 Sewage lagoon 11 Fuel storage 15 Oil well/Gas well  
 3 Watertight sewer lines 6 Seepage pit 9 Feedyard 12 Fertilizer storage 16 Other (specify below)  
 13 Insecticide storage

Direction from well? south How many feet? 265'

FROM	TO	LITHOLOGIC LOG	FROM	TO	PLUGGING INTERVALS
0	2	Top Soil	137	139	Limestone-Yellow-Loose
2	49	Clay-Brown	139	144	Shale-Grey
49	63	Clay-Blue	144	160	Shale-Grey
63	64	Boulders			
64	70	Clay-Blue			
70	72	Boulders			
72	77	Clay-Blue			
77	79	Boulders			
79	81	Clay-Brown			
81	92	Clay-Blue			
94	105	Shale-Yellow			
105	107	Shale-Grey			
107	124	Limestone-Grey-Hard			
124	126	Limestone-Yellow-Loose			
126	137	Shale-Grey			

7 CONTRACTOR'S OR LANDOWNER'S CERTIFICATION: This water well was (1) constructed, (2) reconstructed, or (3) plugged under my jurisdiction and was completed on (mo/day/year) 11-14-90 and this record is true to the best of my knowledge and belief. Kansas Water Well Contractor's License No. 182 This Water Well Record was completed on (mo/day/yr) 12-5-90 under the business name of STRADER DRILLING CO., Inc. by (signature) Dal Bakran