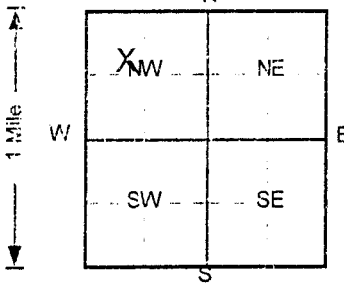


1 LOCATION OF WATER WELL:		Fraction	Section Number	Township Number	Range Number
County: Brown		SE 1/4 NW 1/4 NW 1/4	34	T 2 S	R 15 EW
Distance and direction from nearest town or city street address of well if located within city? 50' N & 50' E of Old USDA grain bins, Fairview					
2 WATER WELL OWNER: KDHE-BER					
RR#, St Address, Box # : Building 740, Forbes Field			Board of Agriculture, Division of Water Resources		
City, State, ZIP Code : Topeka, Kansas 66620			Application Number:		
3 LOCATE WELL'S LOCATION WITH AN "X" IN SECTION BOX:		4 DEPTH OF COMPLETED WELL: 105 ft. ELEVATION: 1220.04			
		Depth(s) Groundwater Encountered 1. ft 2. ft 3. ft			
		WELL'S STATIC WATER LEVEL 30.49 ft below land surface measured on mo/day/yr 7/6/95			
		Pump test data: Well water was ft after hours pumping gpm			
		Est. Yield NA gpm: Well water was ft after hours pumping gpm			
Bore Hole Diameter 8 in. to 110 ft, and in. to ft		WELL WATER TO BE USED AS:			
1 Domestic 3 Feedlot 6 Oil field water supply 9 Dewatering 11 Injection well		2 Irrigation 4 Industrial 7 Lawn and garden only 10 Monitoring well 12 Other (Specify below)			
Was a chemical/bacteriological sample submitted to Department? Yes.....No <input checked="" type="checkbox"/>; If yes, mo/day/yr sample was submitted		Water Well Disinfected? Yes No <input checked="" type="checkbox"/>			
5 TYPE OF BLANK CASING USED:					
1 Steel 3 RMP (SR) 5 Wrought iron 8 Concrete tile CASING JOINTS: Glued Clamped					
2 PVC 4 ABS 6 Asbestos-Cement 9 Other (specify below) Welded					
7 Fiberglass Threaded <input checked="" type="checkbox"/>					
Blank casing diameter 4 in. to 85 ft, Dia in. to ft, Dia in. to ft					
Casing height above land surface 4 in., weight lbs./ft. Wall thickness or gauge No. Sch. 40					
TYPE OF SCREEN OR PERFORATION MATERIAL:					
1 Steel 3 Stainless steel 5 Fiberglass 7 PVC 10 Asbestos-cement					
2 Brass 4 Galvanized steel 6 Concrete tile 8 RMP (SR) 11 Other (specify)					
9 ABS 12 None used (open hole)					
SCREEN OR PERFORATION OPENINGS ARE:					
1 Continuous slot 3 Mill slot 5 Gauzed wrapped 8 Saw cut 11 None (open hole)					
2 Louvered shutter 4 Key punched 6 Wire wrapped 9 Drilled holes					
7 Torch cut 10 Other (specify)					
SCREEN-PERFORATED INTERVALS: From 85 ft to 105 ft, From ft to ft					
From ft to ft, From ft to ft					
GRAVEL PACK INTERVALS: From 84 ft to 110 ft, From ft to ft					
From ft to ft, From ft to ft					
6 GROUT MATERIAL: 1 Neat cement 2 Cement grout 3 Bentonite 4 Other					
Grout intervals: From 0 ft to 52 ft, From 52 ft to 84 ft, From ft to ft					
What is the nearest source of possible contamination:					
1 Septic tank 4 Lateral lines 7 Pit privy 10 Livestock pens 14 Abandoned water well					
2 Sewer lines 5 Cess pool 8 Sewage lagoon 11 Fuel storage 15 Oil well/Gas well					
3 Watertight sewer lines 6 Seepage pit 9 Feedyard 12 Fertilizer storage 16 Other (specify below)					
13 Insecticide storage Grain Storage					
Direction from well? SE How many feet? 100					
FROM TO LITHOLOGIC LOG FROM TO PLUGGING INTERVALS					
0	2	Clay, Dark Brown	62	67.5	Shale, Very Dark Gray to Black
2	4	Clay, Medium Red Brown	67.5	69.5	Limestone, Light Brown Gray
4	7	Shale, Tan to Yellow	69.5	77	Shale, Light Gray Brown
7	13	Limestone, Tan to Yellow Brown	77	81	Limestone, Gray Brown
13	16	Shale, Light Yellow Brown	81	85	Shale, Gray
16	21.5	Shale, Green	85	87.5	Limestone, Light Gray Brown
21.5	22.5	Limestone, Light Gray	87.5	95	Shale, Yellow Brown
22.5	32	Shale, Green	95	103	Shale, Pale Green
32	37	Shale, Green, Gray to Gray Green	103	110	Shale, Pale Gray to Green
37	45	Shale, Red to Maroon			
45	51	Shale, Red Brown			
51	53	Shale, Gray Green			
53	59.5	Limestone, Brown to Gray Brown			MW11D, Tag # 00117168, Flushmount
59.5	60	Shale, Very Dark Gray			Project Name: Fairview
60	62	Limestone, Brown to Yellow Brown			GeoCore # 11, # 133102
7 CONTRACTOR'S OR LANDOWNER'S CERTIFICATION: This water well was 1 constructed, (2) reconstructed, or (3) plugged under my jurisdiction and was completed on (mo/day/year) 8/31/95 and this record is true to the best of my knowledge and belief.					
Kansas Water Well Contractor's License No. 527 This Water Well Record was completed on (mo/day/yr) 9/1/95					
under the business name of GeoCore Services, Inc. by (signature) <i>Debi Ruff</i>					