

1 LOCATION OF WATER WELL:	Fraction	Section Number	Township Number	Range Number
County: <b>Brown</b>	<b>NE ¼ NW ¼ NW ¼</b>	<b>34</b>	<b>T 2 S</b>	<b>R 15 EW</b>

Distance and direction from nearest town or city street address of well if located within city?

NW corner of Walnut &amp; Front St., Fairview

## 2 WATER WELL OWNER: KDHE-BER


RR#, St. Address, Box # : Building 740, Forbes Field

Board of Agriculture, Division of Water Resources

City, State, ZIP Code : Topeka, Kansas 66620

Application Number:

## 3 LOCATE WELL'S LOCATION WITH AN "X" IN SECTION BOX:

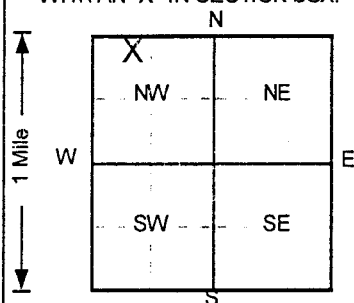

## 4 DEPTH OF COMPLETED WELL: 111 ft ELEVATION: 1217.82

Depth(s) Groundwater Encountered 1. ft 2. ft 3. ft

WELL'S STATIC WATER LEVEL: 28.6 ft below land surface measured on mo/day/yr 7/6/95

Pump test data: Well water was NA ft after hours pumping gpm

Est. Yield NA gpm: Well water was ft after hours pumping gpm

Bore Hole Diameter 8 in. to 115 ft, and in. to ft

WELL WATER TO BE USED AS: 5 Public water supply 8 Air conditioning 11 Injection well

1 Domestic 3 Feedlot 6 Oil field water supply 9 Dewatering 12 Other (Specify below)

2 Irrigation 4 Industrial 7 Lawn and garden only 10 Monitoring well

Was a chemical/bacteriological sample submitted to Department? Yes No If yes, mo/day/yr sample was submitted

Water Well Disinfected? Yes No

## 5 TYPE OF BLANK CASING USED:

1 Steel 3 RMP (SR)

5 Wrought iron

8 Concrete tile

CASING JOINTS: Glued Clamped

2 PVC 4 ABS

6 Asbestos-Cement

9 Other (specify below)

Welded

Blank casing diameter 4 in. to 91 ft, Dia in. to ft, Dia in. to ft

Casing height above land surface -2 in. weight lbs./ft. Wall thickness or gauge No. Sch. 40

## TYPE OF SCREEN OR PERFORATION MATERIAL

1 Steel 3 Stainless steel

5 Fiberglass

7 PVC

10 Asbestos-cement

2 Brass 4 Galvanized steel

6 Concrete tile

8 RMP (SR)

11 Other (specify)

SCREEN OR PERFORATION OPENINGS ARE:

5 Gauzed wrapped

8 Saw cut

11 None (open hole)

1 Continuous slot 3 Mill slot

6 Wire wrapped

9 Drilled holes

2 Louvered shutter 4 Key punched

7 Torch cut

10 Other (specify)

SCREEN-PERFORATED INTERVALS: From 91 ft to 111 ft, From ft to ft

From ft to ft, From ft to ft

GRAVEL PACK INTERVALS: From 89.5 ft to 115 ft, From ft to ft

From ft to ft, From ft to ft

## 6 GROUT MATERIAL:

1 Neat cement

2 Cement grout

3 Bentonite

4 Other

Grout intervals: From 0 ft to 49 ft, From 49 ft to 89.5 ft, From ft to ft

What is the nearest source of possible contamination:

1 Septic tank

4 Lateral lines

7 Pit privy

10 Livestock pens

14 Abandoned water well

2 Sewer lines

5 Cess pool

8 Sewage lagoon

11 Fuel storage

15 Oil well/Gas well

3 Watertight sewer lines

6 Seepage pit

9 Feedyard

12 Fertilizer storage

16 Other (specify below)

13 Insecticide storage

Grain Storage

Direction from well? S

How many feet? 200

FROM	TO	LITHOLOGIC LOG	FROM	TO	PLUGGING INTERVALS
0	2	Clay, Dark Brown	70	75	Shale, Very Dark Gray to Black
2	6	Clay, Brown to Gray Brown	75	78	Limestone, Light Gray Brown
6	14	Clay, Gray to Brown Gray	78	84	Shale, Yellow Brown
14	21	Limestone, Gray to Brown Gray	84	88	Limestone, Light to Medium Brown
21	24	Shale, Green	88	91	Shale, Gray
24	27	Shale, Blue Green	91	94	Limestone, Light Gray Brown
27	28	Shale, Medium to Light Gray	94	96	Shale, Gray Green
28	29.5	Limestone, Gray Green to Gray	96	97	Limestone, Gray Brown
29.5	38	Shale, Green to Blue Green	97	115	Shale, Green
38	40	Shale, Medium to Light Gray			
40	48	Shale, Green			
48	54	Shale, Red to Maroon			
54	61	Shale, Red Brown			MW12D, Tag # 00117236, Flushmount
61	65	Limestone, Light Gray Brown			Project Name: Fairview
65	70	Shale, Light Gray to Gray Brown			GeoCore # 11, # 133102

7 CONTRACTOR'S OR LANDOWNER'S CERTIFICATION: This water well was (1) constructed, (2) reconstructed, or (3) plugged under my jurisdiction and was completed on (mo/day/year) 8/31/95 and this record is true to the best of my knowledge and belief.

Kansas Water Well Contractor's License No. 527 This Water Well Record was completed on (mo/day/yr) 9/1/95

under the business name of

GeoCore Services, Inc.

by (signature)

Dale Relf