WATER WELL RECORD Form WWC-5 KSA 82a-1212

1 LOCATION OF WATER WELL: County: **Brown** | Fraction: **SE ¼ NW ¼ NW ¼** | Section Number: **34** | Township Number: **T 2 S** | Range Number: **R 15 (E)W**

Distance and direction from nearest town or city street address of well if located within city?
NW corner of Walnut & Front St., Fairview

2 WATER WELL OWNER: **KDHE-BER**
RR#, St. Address, Box # : **Building 740, Forbes Field**
City, State, ZIP Code : **Topeka, Kansas 66620**
Board of Agriculture, Division of Water Resources Application Number:

3 LOCATE WELL'S LOCATION WITH AN "X" IN SECTION BOX:

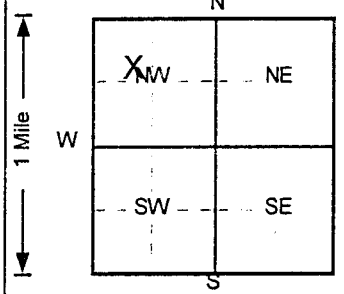

4 DEPTH OF COMPLETED WELL **88** ft. ELEVATION: **1217.81**
Depth(s) Groundwater Encountered 1. ft. 2. ft. 3. ft.
WELL'S STATIC WATER LEVEL **28.84** ft. below land surface measured on mo/day/yr **7/6/95**
Pump test data: Well water was **NA** ft. after hours pumping gpm
Est. Yield **NA** gpm: Well water was ft. after hours pumping gpm
Bore Hole Diameter **8** in. to **90** ft., and in. to ft.
WELL WATER TO BE USED AS: 5 Public water supply 8 Air conditioning 11 Injection well
1 Domestic 3 Feedlot 6 Oil field water supply 9 Dewatering 12 Other (Specify below)
2 Irrigation 4 Industrial 7 Lawn and garden only (10) Monitoring well
Was a chemical/bacteriological sample submitted to Department? Yes.....No.✓.....; If yes, mo/day/yr sample was submitted Water Well Disinfected? Yes No ✓

5 TYPE OF BLANK CASING USED: 5 Wrought iron 8 Concrete tile CASING JOINTS: Glued Clamped
1 Steel 3 RMP (SR) 6 Asbestos-Cement 9 Other (specify below) Welded
(2) PVC 4 ABS 7 Fiberglass Threaded ✓
Blank casing diameter **4** in. to **58** ft., Dia in. to ft., Dia in. to ft.
Casing height above land surface **-2** in., weight lbs./ft. Wall thickness or gauge No. **Sch. 40**

TYPE OF SCREEN OR PERFORATION MATERIAL
1 Steel 3 Stainless steel 5 Fiberglass (7) PVC 10 Asbestos-cement
2 Brass 4 Galvanized steel 6 Concrete tile 8 RMP (SR) 11 Other (specify)
9 ABS 12 None used (open hole)

SCREEN OR PERFORATION OPENINGS ARE:
1 Continuous slot (3) Mill slot 5 Gauzed wrapped 8 Saw cut 11 None (open hole)
2 Louvered shutter 4 Key punched 6 Wire wrapped 9 Drilled holes
7 Torch cut 10 Other (specify)

SCREEN-PERFORATED INTERVALS: From **58** ft. to **88** ft., From ft. to ft.
From ft. to ft., From ft. to ft.
GRAVEL PACK INTERVALS: From **54** ft. to **90** ft., From ft. to ft.
From ft. to ft., From ft. to ft.

6 GROUT MATERIAL: 1 Neat cement (2) Cement grout (3) Bentonite 4 Other
Grout Intervals: From **0** ft. to **14** ft., From **14** ft. to **54** ft., From ft. to ft.

What is the nearest source of possible contamination:
1 Septic tank 4 Lateral lines 7 Pit privy 10 Livestock pens 14 Abandoned water well
2 Sewer lines 5 Cess pool 8 Sewage lagoon 11 Fuel storage 15 Oil well/Gas well
3 Watertight sewer lines 6 Seepage pit 9 Feedyard 12 Fertilizer storage (16) Other (specify below)
13 Insecticide storage **Grain Storage**
Direction from well? **S** How many feet? **200**

FROM	TO	LITHOLOGIC LOG	FROM	TO	PLUGGING INTERVALS
0	2	Clay, Dark Brown	47	48	Shale, Pale Green
2	6	Cllay, Brown to Gray Brown	48	54	Shale, Red to Maroon
6	14	Clay, Gray to Brown Gray	54	61	Shale, Red Brown
14	21	Limestone, Gray to Brown Gray	61	65	Limestone, Light Gray Brown
21	24	Shale, Green	65	70	Shale, Light Gray to Gray Brown
24	27	Shale, Blue Green	70	75	Shale, Very Dark Gray to Black
27	28	Shale, Medium to Light Gray	75	78	Limestone, Light Gray Brown
28	29.5	Limestone, Gray Green to Gray	78	84	Shale, Yellow Brown
29.5	38	Shale, Green to Blue Green	84	88	Limestone, Light to Medium Brown
38	40	Shale, Medium to Light Gray	88	90	Shale, Gray
40	42	Shale, Red to Maroon			
42	43	Shale, Pale Green			
43	44	Shale, Red to Maroon			
44	46	Shale, Green to Pale Green			
46	47	Shale, Red to Maroon			

7 CONTRACTOR'S OR LANDOWNER'S CERTIFICATION: This water well was (1) constructed, (2) reconstructed, or (3) plugged under my jurisdiction and was completed on (mo/day/year) **8/31/95** and this record is true to the best of my knowledge and belief. Kansas Water Well Contractor's License No. **527** This Water Well Record was completed on (mo/day/yr) **9/1/95** under the business name of **GeoCore Services, Inc.** by (signature) Dale Kahl

INSTRUCTIONS: Use typewriter or ball point pen. *PLEASE PRESS FIRMLY* and *PRINT* clearly. Please fill in blanks, underline or circle the correct answers. Send top three copies to Kansas Department of Health and Environment, Bureau of Water, Topeka, Kansas 66620-0001. Telephone: 913-296-5545. Send one to WATER WELL OWNER and retain one for your records.

OFFICE USE ONLY T R E/W SEC. ¼ ¼ ¼