


| | | | | |
|---|-----------------------------------|-----------------------------|---------------------------------|-------------------------------|
| 1 LOCATION OF WATER WELL: County: Brown | Fraction NE ¼ SE ¼ SW ¼ | Section Number 27 | Township Number T 2 S | Range Number R 15 E |
|---|-----------------------------------|-----------------------------|---------------------------------|-------------------------------|

Distance and direction from nearest town or city street address of well if located within city?

North of low income housing, Fairview

2 WATER WELL OWNER: **KDHE-BER**
 RR#, St. Address, Box # : **Building 740, Forbes Field**
 City, State, ZIP Code : **Topeka, Kansas 66620**
 Board of Agriculture, Division of Water Resources
 Application Number:

3 LOCATE WELL'S LOCATION WITH AN "X" IN SECTION BOX:

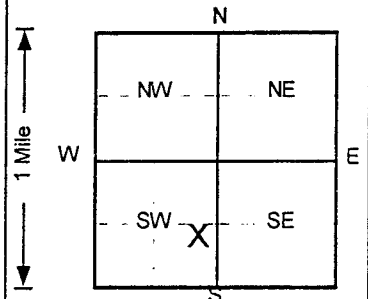

4 DEPTH OF COMPLETED WELL **123** ft ELEVATION: **1223.9**
 Depth(s) Groundwater Encountered 1. ft 2. ft 3. ft
 WELL'S STATIC WATER LEVEL ... **42.04** ... ft below land surface measured on **mo/day/yr** **7/6/95**
 Pump test data: Well water was ... **NA** ... ft after hours pumping gpm
 Est. Yield .. **NA** .. gpm: Well water was ft after hours pumping gpm
 Bore Hole Diameter ... **8** ... in. to ... **127** ... ft, and, in. to ft
 WELL WATER TO BE USED AS: 5 Public water supply 8 Air conditioning 11 Injection well
 1 Domestic 3 Feedlot 6 Oil field water supply 9 Dewatering 12 Other (Specify below)
 2 Irrigation 4 Industrial 7 Lawn and garden only **10** Monitoring well
 Was a chemical/bacteriological sample submitted to Department? Yes.....No; If yes, mo/day/yr sample was submitted
 Water Well Disinfected? Yes No

5 TYPE OF BLANK CASING USED:
 1 Steel 3 RMP (SR) 5 Wrought iron 8 Concrete tile CASING JOINTS: Glued Clamped
2 PVC 4 ABS 6 Asbestos-Cement 9 Other (specify below) Welded
 7 Fiberglass Threaded.
 Blank casing diameter **4** in. to **103** ft, Dia in. to ft, Dia in. to ft
 Casing height above land surface **3** in., weight lbs./ft. Wall thickness or gauge No. **Sch. 40**
 TYPE OF SCREEN OR PERFORATION MATERIAL **7** PVC 10 Asbestos-cement
 1 Steel 3 Stainless steel 5 Fiberglass 8 RMP (SR) 11 Other (specify)
 2 Brass 4 Galvanized steel 6 Concrete tile 9 ABS 12 None used (open hole)
 SCREEN OR PERFORATION OPENINGS ARE:
 1 Continuous slot **3** Mill slot 5 Gauzed wrapped 8 Saw cut 11 None (open hole)
 2 Louvered shutter 4 Key punched 6 Wire wrapped 9 Drilled holes
 7 Torch cut 10 Other (specify)
 SCREEN-PERFORATED INTERVALS: From **103** ft to **123** ft, From ft to ft
 From ft to ft, From ft to ft
 GRAVEL PACK INTERVALS: From **102** ft to **127** ft, From ft to ft
 From ft to ft, From ft to ft

6 GROUT MATERIAL: 1 Neat cement **2** Cement grout **3** Bentonite 4 Other
 Grout intervals: From **0** ft to **49** ft, From **49** ft to **102** ft, From ft to ft
 What is the nearest source of possible contamination:
 1 Septic tank 4 Lateral lines 7 Pit privy 10 Livestock pens 14 Abandoned water well
 2 Sewer lines 5 Cess pool 8 Sewage lagoon 11 Fuel storage 15 Oil well/Gas well
 3 Watertight sewer lines 6 Seepage pit 9 Feedyard 12 Fertilizer storage **16** Other (specify below)
 **Grain Storage**
 Direction from well? **SW** How many feet? **1300**

| FROM | TO | LITHOLOGIC LOG | FROM | TO | PLUGGING INTERVALS |
|------|----|-------------------------------|-------|-------|---------------------------------|
| 0 | 2 | Clay, Dark Brown | 82 | 87 | Shale, Very Dark Brown to Black |
| 2 | 4 | Clay, Brown | 87 | 89 | Limestone, Gray to Brown Gray |
| 4 | 15 | Clay, Red Brown | 89 | 93 | Shale, Gray |
| 15 | 17 | Shale, Green to Light Gray | 93 | 96 | Shale, Yellow Brown |
| 17 | 21 | Limestone, Brown | 96 | 99 | Limestone, Tan to Yellow Brown |
| 21 | 24 | Shale, Light Gray | 99 | 104 | Shale, Gray |
| 24 | 31 | Shale, Light Gray | 104 | 107 | Limestone, Gray Brown |
| 31 | 36 | Shale, Light Gray Brown | 107 | 109 | Shale, Gray |
| 36 | 49 | Shale, Green to Gray Green | 109 | 109.5 | Limestone, Gray |
| 49 | 51 | Shale, Gray | 109.5 | 120 | Shale, Green to Gray Green |
| 51 | 53 | Shale, Green to Gray Green | 120 | 127 | Shale, Green |
| 53 | 66 | Shale, Red to Maroon | | | |
| 66 | 72 | Shale, Red Brown | | | |
| 72 | 78 | Limestone, Gray to Gray Brown | | | |
| 78 | 82 | Shale, Gray | | | |

7 CONTRACTOR'S OR LANDOWNER'S CERTIFICATION: This water well was **1** constructed, **2** reconstructed, or **3** plugged under my jurisdiction and was completed on (mo/day/year) **8/31/95** and this record is true to the best of my knowledge and belief.
 Kansas Water Well Contractor's License No. **527** This Water Well Record was completed on (mo/day/yr) **9/1/95**
 under the business name of **GeoCore Services, Inc.** by (signature) *Dale Pohl*

INSTRUCTIONS: Use typewriter or ball point pen. PLEASE PRESS FIRMLY and PRINT clearly. Please fill in blanks, underline or circle the correct answers. Send top three copies to Kansas Department of Health and Environment, Bureau of Water, Topeka, Kansas 66620-0001. Telephone: 913-296-5545. Send one to WATER WELL OWNER and retain one for your records.

OFFICE USE ONLY
T
R
EM
SEC
1/4
1/4
1/4