


1] LOCATION OF WATER WELL: Fraction NE 1/4 SE 1/4 SW 1/4 Section Number 27 Township Number T 2 S Range Number R 15 EW

Distance and direction from nearest town or city street address of well if located within city?

North of low income housing, Fairview

2] WATER WELL OWNER: KDHE-BER RR# St. Address, Box# : Building 740, Forbes Field Board of Agriculture, Division of Water Resources City, State, ZIP Code : Topeka, Kansas 66620 Application Number:

3] LOCATE WELL'S LOCATION WITH AN "X" IN SECTION BOX:

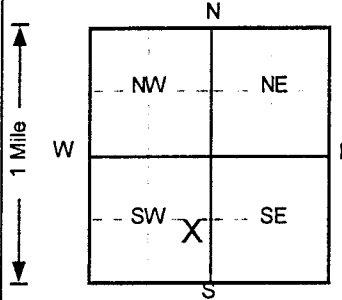

4] DEPTH OF COMPLETED WELL 31 ft ELEVATION: 1223.91

Depth(s) Groundwater Encountered 1. ft 2. ft 3. ft
WELL'S STATIC WATER LEVEL . . . 15.21 . . . ft below land surface measured on mo/day/yr . . . 7/7/95 . . .

Pump test data: Well water was . . . NA . . . ft after . . . hours pumping . . . gpm
Est. Yield . . NA . . . gpm: Well water was . . . ft after . . . hours pumping . . . gpm

Bore Hole Diameter . . . 8 . . . in. to . . . 31 . . . ft, and . . . in. to . . . ft

- WELL WATER TO BE USED AS: 5 Public water supply 8 Air conditioning 11 Injection well
1 Domestic 3 Feedlot 6 Oil field water supply 9 Dewatering 12 Other (Specify below)
2 Irrigation 4 Industrial 7 Lawn and garden only 10 Monitoring well

Was a chemical/bacteriological sample submitted to Department? Yes.....No[checked].....; If yes, mo/day/yr sample was submitted Water Well Disinfected? Yes No[checked]

5] TYPE OF BLANK CASING USED: 1 Steel 3 RMP (SR) 5 Wrought iron 8 Concrete tile CASING JOINTS: Glued Clamped 2 PVC 4 ABS 6 Asbestos-Cement 9 Other (specify below) Welded Threaded [checked]

Blank casing diameter 2 in. to 16 ft, Dia in. to ft, Dia in. to ft
Casing height above land surface -5 in., weight lbs./ft. Wall thickness or gauge No. Sch. 40

TYPE OF SCREEN OR PERFORATION MATERIAL: 1 Steel 3 Stainless steel 5 Fiberglass 7 PVC 10 Asbestos-cement 2 Brass 4 Galvanized steel 6 Concrete tile 8 RMP (SR) 11 Other (specify) 12 None used (open hole)

SCREEN OR PERFORATION OPENINGS ARE: 1 Continuous slot 2 Louvered shutter 3 Mill slot 4 Key punched 5 Gauzed wrapped 6 Wire wrapped 7 Torch cut 8 Saw cut 9 Drilled holes 10 Other (specify) 11 None (open hole)

SCREEN-PERFORATED INTERVALS: From 16 ft to 31 ft, From ft to ft
GRAVEL PACK INTERVALS: From 14 ft to 31 ft, From ft to ft

6] GROUT MATERIAL: 1 Neat cement 2 Cement grout 3 Bentonite 4 Other Grout Intervals: From 0 ft to 4 ft, From 4 ft to 14 ft, From ft to ft

What is the nearest source of possible contamination: 1 Septic tank 2 Sewer lines 3 Watertight sewer lines 4 Lateral lines 5 Cess pool 6 Seepage pit 7 Pit privy 8 Sewage lagoon 9 Feedyard 10 Livestock pens 11 Fuel storage 12 Fertilizer storage 13 Insecticide storage 14 Abandoned water well 15 Oil well/Gas well 16 Other (specify below) Grain Storage

Direction from well? SW How many feet? 1300

FROM	TO	LITHOLOGIC LOG	FROM	TO	PLUGGING INTERVALS
0	2	Clay, Dark Brown			
2	4	Clay, Brown			
4	15	Clay, Red-Brown			
15	17	Shale, Green-Light Gray			
17	21	Limestone, Brown			
21	24	Shale, Light Gray			
24	31	Shale, Light Gray			

7] CONTRACTOR'S OR LANDOWNER'S CERTIFICATION: This water well was (1) constructed, (2) reconstructed, or (3) plugged under my jurisdiction and was completed on (mo/day/year) 8/31/95 and this record is true to the best of my knowledge and belief. Kansas Water Well Contractor's License No. 527 This Water Well Record was completed on (mo/day/yr) 9/1/95 under the business name of GeoCore Services, Inc. by (signature) Dale Rohlf

OFFICE USE ONLY
T
R
EWM
SEC.
1/4
1/4
1/4