


1 LOCATION OF WATER WELL: Fraction **SW 1/4 SE 1/4 SW 1/4** Section Number **27** Township Number **T 2 S** Range Number **R 15 EW**
 County: **Brown**

Distance and direction from nearest town or city street address of well if located within city?
200' N of Ash & 2nd

2 WATER WELL OWNER: **KDHE-BER**
 RR#, St. Address, Box # : **Building 740, Forbes Field** Board of Agriculture, Division of Water Resources
 City, State, ZIP Code : **Topeka, Kansas 66620** Application Number:

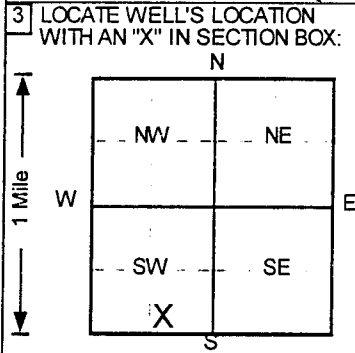

4 DEPTH OF COMPLETED WELL **94** ft ELEVATION: **1223.84**
 Depth(s) Groundwater Encountered 1. ft 2. ft 3. ft
 WELL'S STATIC WATER LEVEL **42.47** ft below land surface measured on **mo/day/yr** **7/1/795**
 Pump test data: Well water was **NA** ft after hours pumping gpm
 Est. Yield **NA** gpm: Well water was ft after hours pumping gpm
 Bore Hole Diameter **8** in. to **96** ft, and in. to ft
 WELL WATER TO BE USED AS: 5 Public water supply 8 Air conditioning 11 Injection well
 1 Domestic 3 Feedlot 6 Oil field water supply 9 Dewatering 12 Other (Specify below)
 2 Irrigation 4 Industrial 7 Lawn and garden only **10** Monitoring well
 Was a chemical/bacteriological sample submitted to Department? Yes.....No ; If yes, mo/day/yr sample was submitted
 Water Well Disinfected? Yes No

5 TYPE OF BLANK CASING USED: 5 Wrought iron 8 Concrete tile CASING JOINTS: Glued Clamped
 1 Steel 3 RMP (SR) 6 Asbestos-Cement 9 Other (specify below) Welded
2 PVC 4 ABS 7 Fiberglass Threaded.
 Blank casing diameter **4** in. to **64** ft, Dia in. to ft, Dia in. to ft
 Casing height above land surface **-4** in., weight lbs./ft. Wall thickness or gauge No. **Sch. 40**
 TYPE OF SCREEN OR PERFORATION MATERIAL **7** PVC 10 Asbestos-cement
 1 Steel 3 Stainless steel 5 Fiberglass **8** RMP (SR) 11 Other (specify)
 2 Brass 4 Galvanized steel 6 Concrete tile 9 ABS 12 None used (open hole)
 SCREEN OR PERFORATION OPENINGS ARE: 5 Gauzed wrapped 8 Saw cut 11 None (open hole)
 1 Continuous slot **3** Mill slot 6 Wire wrapped 9 Drilled holes
 2 Louvered shutter 4 Key punched 7 Torch cut 10 Other (specify)
 SCREEN-PERFORATED INTERVALS: From **64** ft to **94** ft, From ft to ft
 From ft to ft, From ft to ft
 GRAVEL PACK INTERVALS: From **60** ft to **96** ft, From ft to ft
 From ft to ft, From ft to ft

6 GROUT MATERIAL: 1 Neat cement **2** Cement grout **3** Bentonite 4 Other
 Grout intervals: From **0** ft to **17** ft, From **17** ft to **60** ft, From ft to ft
 What is the nearest source of possible contamination:
 1 Septic tank 4 Lateral lines 7 Pit privy 10 Livestock pens 14 Abandoned water well
 2 Sewer lines 5 Cess pool 8 Sewage lagoon 11 Fuel storage 15 Oil well/Gas well
 3 Watertight sewer lines 6 Seepage pit 9 Feedyard 12 Fertilizer storage **16** Other (specify below)
 **Grain Storage**
 Direction from well? **S** How many feet? **1250**

FROM	TO	LITHOLOGIC LOG	FROM	TO	PLUGGING INTERVALS
0	1	Clay, Dark Brown	77	81	Shale, Dark Gray to Black
1	4	Clay, Brown	81	84	Limestone, Gray Brown
4	13	Clay, Red Brown	84	86.5	Shale, Yellow Brown to Brown
13	19.5	Shale, Light Yellow Brown	86.5	87.5	Limestone, Gray Brown
19.5	25	Limestone, Light Yellow Brown	87.5	90.5	Shale, Yellow Brown
25	28	Shale, Light Green	90.5	93.5	Limestone, Gray to Light Gray
28	32	Shale, Green	93.5	96	Shale, Gray
32	35	Limestone, Light Yellow Brown			
35	38	Shale, Gray Green			
38	41	Shale, Dark Green			
41	60	Shale, Red to Maroon			
60	65	Shale, Red Brown			
65	69	Limestone, Gray Brown			MW151, Tag # 00117175, Flushmount
69	74	Shale, Gray			Project Name: Fairview
74	77	Limestone, Gray			GeoCore # 11, # 133102

7 CONTRACTOR'S OR LANDOWNER'S CERTIFICATION: This water well was **1** constructed, (2) reconstructed, or (3) plugged under my jurisdiction and was completed on (mo/day/year) **8/31/95** and this record is true to the best of my knowledge and belief.
 Kansas Water Well Contractor's License No. **527**. This Water Well Record was completed on (mo/day/yr) **9/1/95** under the business name of **GeoCore Services, Inc.** by (signature) *Don Roll*

INSTRUCTIONS: Use typewriter or ball point pen. PLEASE PRESS FIRMLY and PRINT clearly. Please fill in blanks, underline or circle the correct answers. Send top three copies to Kansas Department of Health and Environment, Bureau of Water, Topeka, Kansas 66620-0001. Telephone: 913-296-5545. Send one to WATER WELL OWNER and retain one for your records.

OFFICE USE ONLY

T

R

EW

SEC.

1/2

1/2

1/2