

**WATER WELL RECORD Form WWC-5 KSA 82a-1212**


1 LOCATION OF WATER WELL:	Fraction	Section Number	Township Number	Range Number
County: <u>BROWN</u>	<u>SE 1/4 SE 1/4 SW 1/4</u>	<u>5</u>	<u>T 2 S</u>	<u>R 15E E/W</u>

Distance and direction from nearest town or city street address of well if located within city?  
1 1/2 mile east of Sabetha

2 WATER WELL OWNER: James Aberle  
 RR#, St. Address, Box # : Rt. 2 Box 21  
 City, State, ZIP Code : Sabetha, KS 66534

Board of Agriculture, Division of Water Resources  
 Application Number:

3 LOCATE WELL'S LOCATION WITH AN "X" IN SECTION BOX:

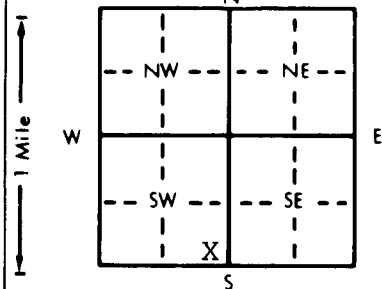

4 DEPTH OF COMPLETED WELL: 160 ft. ELEVATION:

Depth(s) Groundwater Encountered 1. 135' ft. 2. \_\_\_\_\_ ft. 3. \_\_\_\_\_ ft.  
 WELL'S STATIC WATER LEVEL 123' ft. below land surface measured on mo/day/yr 12-4-90  
 Pump test data: Well water was \_\_\_\_\_ ft. after \_\_\_\_\_ hours pumping \_\_\_\_\_ gpm  
 Est. Yield 5 gpm: Well water was \_\_\_\_\_ ft. after \_\_\_\_\_ hours pumping \_\_\_\_\_ gpm  
 Bore Hole Diameter 8 3/4 in. to \_\_\_\_\_ ft., and \_\_\_\_\_ in. to \_\_\_\_\_ ft.  
 WELL WATER TO BE USED AS:  
 1 Domestic \_\_\_\_\_ 2 Irrigation \_\_\_\_\_ 3 Feedlot \_\_\_\_\_ 4 Industrial \_\_\_\_\_  
 5 Public water supply \_\_\_\_\_ 6 Oil field water supply \_\_\_\_\_ 7 Lawn and garden only \_\_\_\_\_  
 8 Air conditioning \_\_\_\_\_ 9 Dewatering \_\_\_\_\_ 10 Monitoring well \_\_\_\_\_  
 11 Injection well \_\_\_\_\_ 12 Other (Specify below) \_\_\_\_\_  
 Was a chemical/bacteriological sample submitted to Department? Yes \_\_\_\_\_ No X \_\_\_\_\_; If yes, mo/day/yr sample was sub-  
 mitted \_\_\_\_\_ Water Well Disinfected? Yes X No \_\_\_\_\_

5 TYPE OF BLANK CASING USED:

1 Steel	3 RMP (SR)	5 Wrought iron	8 Concrete tile	CASING JOINTS: Glued <u>X</u> Clamped _____
2 PVC	4 ABS	6 Asbestos-Cement	9 Other (specify below)	Welded _____
		7 Fiberglass		Threaded _____

Blank casing diameter 5" in. to 0-120 ft., Dia \_\_\_\_\_ in. to \_\_\_\_\_ ft., Dia \_\_\_\_\_ in. to \_\_\_\_\_ ft.  
 Casing height above land surface 24" in., weight 2.82 lbs./ft. Wall thickness or gauge No. 258

TYPE OF SCREEN OR PERFORATION MATERIAL:

1 Steel	3 Stainless steel	5 Fiberglass	7 PVC	10 Asbestos-cement
2 Brass	4 Galvanized steel	6 Concrete tile	8 RMP (SR)	11 Other (specify) _____
			9 ABS	12 None used (open hole)

SCREEN OR PERFORATION OPENINGS ARE:

1 Continuous slot	3 Mill slot	5 Gauzed wrapped	8 Saw cut	11 None (open hole)
2 Louvered shutter	4 Key punched	6 Wire wrapped	9 Drilled holes	
		7 Torch cut	10 Other (specify) _____	

SCREEN-PERFORATED INTERVALS: From 120 ft. to 160 ft., From \_\_\_\_\_ ft. to \_\_\_\_\_ ft.  
 From \_\_\_\_\_ ft. to \_\_\_\_\_ ft., From \_\_\_\_\_ ft. to \_\_\_\_\_ ft.  
 GRAVEL PACK INTERVALS: From 24 ft. to 160 ft., From \_\_\_\_\_ ft. to \_\_\_\_\_ ft.  
 From \_\_\_\_\_ ft. to \_\_\_\_\_ ft., From \_\_\_\_\_ ft. to \_\_\_\_\_ ft.

6 GROUT MATERIAL: 1 Neat cement 2 Cement grout 3 Bentonite 4 Other hole plug

Grout Intervals: From 4 ft. to 24 ft., From \_\_\_\_\_ ft. to \_\_\_\_\_ ft., From \_\_\_\_\_ ft. to \_\_\_\_\_ ft.  
 What is the nearest source of possible contamination:  
 1 Septic tank 4 Lateral lines 7 Pit privy 10 Livestock pens 14 Abandoned water well  
 2 Sewer lines 5 Cess pool 8 Sewage lagoon 11 Fuel storage 15 Oil well/Gas well  
 3 Watertight sewer lines 6 Seepage pit 9 Feedyard 12 Fertilizer storage 16 Other (specify below) \_\_\_\_\_  
 13 Insecticide storage \_\_\_\_\_

Direction from well? EAST How many feet? 148'

FROM	TO	LITHOLOGIC LOG	FROM	TO	PLUGGING INTERVALS
0	2	Top Soil	126	132	Shale-Red
2	39	Clay-Brown	132	137	Limestone-Yellow
39	41	Fine Sand-Coarse Sand-Brown	137	156	Shale-Grey
41	48	Clay-Boulders	156	160	Limestone-Grey
48	57	Clay-Brown			
57	61	Limestone-Grey			
61	65	Shale-Yellow			
65	71	Shale-Grey			
71	72	Limestone-Grey			
72	93	Shale-Grey			
93	97	Limestone-Grey			
97	109	Shale-Grey			
109	113	Limestone-Grey			
113	126	Shale-Grey			

7 CONTRACTOR'S OR LANDOWNER'S CERTIFICATION: This water well was (1) constructed, (2) reconstructed, or (3) plugged under my jurisdiction and was completed on (mo/day/year) 12-04-90 and this record is true to the best of my knowledge and belief. Kansas Water Well Contractor's License No. 182 This Water Well Record was completed on (mo/day/yr) 2-18-91 under the business name of STRADER DRILLING CO., INC. by (signature) Dalshen

INSTRUCTIONS: Use typewriter or ball point pen. PLEASE PRESS FIRMLY and PRINT clearly. Please fill in blanks, underline or circle the correct answers. Send top three copies to Kansas Department of Health and Environment, Bureau of Water, Topeka, Kansas 66620-7320. Telephone: 913-296-5545. Send one to WATER WELL OWNER and retain one for your records.