


1 LOCATION OF WATER WELL: Fraction SW 1/4 SW 1/4 NE 1/4 Section Number 6 Township Number T 2 S Range Number R 15 EW
 County: BROWN

Distance and direction from nearest town or city street address of well if located within city?
 1/4 east of Sabetha

2 WATER WELL OWNER: Farmers Coop Elevator
 RR#, St. Address, Box # : P.O. Box F Board of Agriculture, Division of Water Resources
 City, State, ZIP Code : Sabetha, KS 66534 Application Number:

3 LOCATE WELL'S LOCATION WITH AN "X" IN SECTION BOX:

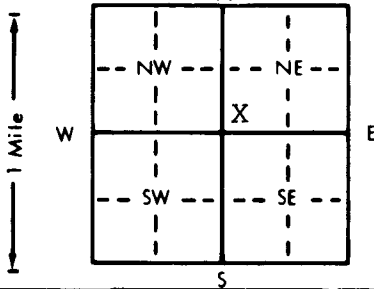

4 DEPTH OF COMPLETED WELL... 160 ft. ELEVATION:
 Depth(s) Groundwater Encountered 1... 117' ft. 2... ft. 3... ft.
 WELL'S STATIC WATER LEVEL ... 87' ft. below land surface measured on mo/day/yr ... 8-24-89
 Pump test data: Well water was ... ft. after ... hours pumping ... gpm
 Est. Yield ... 30 gpm: Well water was ... ft. after ... hours pumping ... gpm
 Bore Hole Diameter 8 3/4 in. to ... ft., and ... in. to ... ft.
 WELL WATER TO BE USED AS: 5 Public water supply 8 Air conditioning 11 Injection well
 1 Domestic 3 Feedlot 6 Oil field water supply 9 Dewatering 12 Other (Specify below)
 2 Irrigation 4 Industrial 7 Lawn and garden only 10 Monitoring well
 Was a chemical/bacteriological sample submitted to Department? Yes... No... X...; If yes, mo/day/yr sample was submitted
 Water Well Disinfected? Yes X No

5 TYPE OF BLANK CASING USED:
 1 Steel 3 RMP (SR) 5 Wrought iron 8 Concrete tile CASING JOINTS: Glued X Clamped
 2 PVC 4 ABS 6 Asbestos-Cement 9 Other (specify below) Welded
 7 Fiberglass Threaded
 Blank casing diameter ... 5" in. to 0-90' ft., Dia 5" in. to 130-160 ft., Dia ... in. to ... ft.
 Casing height above land surface ... 24" in., weight ... 2.82 lbs./ft. Wall thickness or gauge No. ... 258

TYPE OF SCREEN OR PERFORATION MATERIAL:
 1 Steel 3 Stainless steel 5 Fiberglass 8 RMP (SR) 10 Asbestos-cement
 2 Brass 4 Galvanized steel 6 Concrete tile 9 ABS 11 Other (specify)
 12 None used (open hole)

SCREEN OR PERFORATION OPENINGS ARE:
 1 Continuous slot 3 Mill slot 5 Gauzed wrapped 8 Saw cut 11 None (open hole)
 2 Louvered shutter 4 Key punched 6 Wire wrapped 9 Drilled holes
 7 Torch cut 10 Other (specify)

SCREEN-PERFORATED INTERVALS: From ... 90 ft. to ... 130 ft., From ... ft. to ... ft.
 From ... ft. to ... ft., From ... ft. to ... ft.
 GRAVEL PACK INTERVALS: From ... 24 ft. to ... 160 ft., From ... ft. to ... ft.
 From ... ft. to ... ft., From ... ft. to ... ft.

6 GROUT MATERIAL: 1 Neat cement 2 Cement grout 3 Bentonite 4 Other ... hole plug
 Grout Intervals: From ... 4 ft. to ... 24 ft., From ... ft. to ... ft., From ... ft. to ... ft.

What is the nearest source of possible contamination:
 1 Septic tank 4 Lateral lines 7 Pit privy 10 Livestock pens 14 Abandoned water well
 2 Sewer lines 5 Cess pool 8 Sewage lagoon 11 Fuel storage 15 Oil well/Gas well
 3 Watertight sewer lines 6 Seepage pit 9 Feedyard 12 Fertilizer storage 16 Other (specify below)
 13 Insecticide storage
 Direction from well? South How many feet? 400'

FROM	TO	LITHOLOGIC LOG	FROM	TO	PLUGGING INTERVALS
0	18	Clay-Brown	95	117	Shale-Yellow
18	21	Fine Sand-Brown	117	121	Limestone-Yellow-Loose
21	35	Clay-Brown	121	160	Shaley Limestone-Grey
35	38	Fine Sand-Brown			
38	41	Clay-Brown			
41	65	Clay-Brown			
65	72	Shale-Grey			
72	76	Shale-Red			
76	81	Limestone-Yellow			
81	87	Shale-Grey			
87	90	Shale-Red			
90	95	Limestone-Yellow			

7 CONTRACTOR'S OR LANDOWNER'S CERTIFICATION: This water well was (1) constructed, (2) reconstructed, or (3) plugged under my jurisdiction and was completed on (mo/day/year) ... 8-24-89 ... and this record is true to the best of my knowledge and belief. Kansas Water Well Contractor's License No. ... 182 ... This Water Well Record was completed on (mo/day/yr) ... 10-9-89 ... under the business name of STRADER DRILLING CO., INC. by (signature) *Dale Strader*