


1 LOCATION OF WATER WELL: Fraction SW 1/4 SW 1/4 SW 1/4 Section Number 6 Township Number T 2 S Range Number R 15 E/W  
 County: BROWN

Distance and direction from nearest town or city street address of well if located within city?  
EAST edge of Sabetha Ks

2 WATER WELL OWNER: Fred Aberle  
 RR#, St. Address, Box #: 112 S 75th Board of Agriculture, Division of Water Resources  
 City, State, ZIP Code: Sabetha Ks 66534 Application Number:

3 LOCATE WELL'S LOCATION WITH AN "X" IN SECTION BOX:

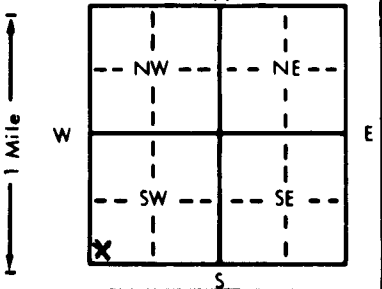

4 DEPTH OF COMPLETED WELL: 13.6 ft. ELEVATION:

Depth(s) Groundwater Encountered 1. 10.3 ft. 2. ft. 3. ft.  
 WELL'S STATIC WATER LEVEL: 73.25 ft. below land surface measured on mo/day/yr 1-15-90  
 Pump test data: Well water was 82.25 ft. after 2 hours pumping 1.7 gpm  
 Est. Yield 5.0 gpm: Well water was ft. after hours pumping gpm  
 Bore Hole Diameter: 8 in. to 13.6 ft., and in. to ft.  
 WELL WATER TO BE USED AS:  
 1 Domestic  3 Feedlot  6 Oil field water supply  9 Dewatering  12 Other (Specify below)  
 2 Irrigation  4 Industrial  7 Lawn and garden only  10 Observation well  
 Was a chemical/bacteriological sample submitted to Department? Yes.....No X.....; If yes, mo/day/yr sample was submitted  
 Water Well Disinfected? Yes X No

5 TYPE OF BLANK CASING USED:  
 1 Steel  3 RMP (SR)  5 Wrought iron  8 Concrete tile CASING JOINTS: Glued X Clamped  
 2 PVC  4 ABS  6 Asbestos-Cement  9 Other (specify below) Welded  
 Blank casing diameter 5 in. to 9.6 ft., Dia. in. to ft., Dia. in. to ft.  
 Casing height above land surface 1.8 in., weight 2.843 lbs./ft. Wall thickness or gauge No. 200 PSI  
 TYPE OF SCREEN OR PERFORATION MATERIAL:  
 1 Steel  3 Stainless steel  5 Fiberglass  7 PVC  10 Asbestos-cement  
 2 Brass  4 Galvanized steel  6 Concrete tile  8 RMP (SR)  11 Other (specify)  
 SCREEN OR PERFORATION OPENINGS ARE:  
 1 Continuous slot  3 Mill slot  5 Gauzed wrapped  8 Saw cut  11 None (open hole)  
 2 Louvered shutter  4 Key punched  6 Wire wrapped  9 Drilled holes  
 7 Torch cut  10 Other (specify)

SCREEN-PERFORATED INTERVALS: From 9.6 ft. to 13.6 ft., From ft. to ft.  
 From ft. to ft., From ft. to ft.

GRAVEL PACK INTERVALS: From 4.0 ft. to 13.6 ft., From ft. to ft.  
 From ft. to ft., From ft. to ft.

6 GROUT MATERIAL:  1 Neat cement  2 Cement grout  3 Bentonite  4 Other

Grout Intervals: From 2 ft. to 19 ft., From ft. to ft., From ft. to ft.

What is the nearest source of possible contamination:  
 1 Septic tank  4 Lateral lines  7 Pit privy  10 Livestock pens  14 Abandoned water well  
 2 Sewer lines  5 Cess pool  8 Sewage lagoon  11 Fuel storage  15 Oil well/Gas well  
 3 Watertight sewer lines  6 Seepage pit  9 Feedyard  12 Fertilizer storage  16 Other (specify below)  
 13 Insecticide storage

Direction from well? How many feet?

FROM	TO	LITHOLOGIC LOG	FROM	TO	LITHOLOGIC LOG
0	4	MS	107	109	Shale Red
4	17	Silty clay BR	109	110	Shale LGRAY
17	52.5	SANDY clay BR	110	114.5	Shale Red
52.5	63	SANDY clay GRAY	111.5	112.5	Shale LGRAY
63	67	SAND pb V-C	112.5	114	Shale Red
67	71	SANDY clay BR	114	118	Shale LGRAY
71	89	SANDY clay GRAY	118	122	LS LGRAY
89	90	Shale GRAY	122	123.6	LS medGRAY
90	92	Shale Red	123.6	126	Shale GRAY
92	93.5	Shale GRAY	126	127.5	Shale LGRAY
93.5	97.5	LS LGRAY	127.5	134	LS LGRAY
97.5	99.5	Shale LGRAY	134	136	LS BR
99.5	103.3	Shale olive			
103.3	104.5	LS GRAY			
104.5	107	Shale GRAY			

7 CONTRACTOR'S OR LANDOWNER'S CERTIFICATION: This water well was  (1) constructed,  (2) reconstructed, or  (3) plugged under my jurisdiction and was completed on (mo/day/year) 1-15-90 and this record is true to the best of my knowledge and belief. Kansas

Water Well Contractor's License No. 305 This Water Well Record was completed on (mo/day/yr) 1-15-90

under the business name of Rieschick Drilling Co by (signature) Ray Rensel

INSTRUCTIONS: Use typewriter or ball point pen. PLEASE PRESS FIRMLY and PRINT clearly. Please fill in blanks, underline or circle the correct answers. Send top three copies to Kansas Department of Health and Environment, Bureau of Water Protection, Topeka, Kansas 66620-7320, Telephone: 913-862-9360. Send one to WATER WELL OWNER and retain one for your records.