


1 LOCATION OF WATER WELL: Fraction NW 1/4 NW 1/4 NW 1/4 Section Number 7 Township Number T 2 S Range Number R 15 E
 County: Brown
 Distance and direction from nearest town or city street address of well if located within city?

512 S 75 Hwy Sabotha

2 WATER WELL OWNER: Edelman Inc.
 RR#, St. Address, Box #: 512 S 75 Hwy Board of Agriculture, Division of Water Resources
 City, State, ZIP Code: Sabetha KS 66534 Application Number:

3 LOCATE WELL'S LOCATION WITH AN "X" IN SECTION BOX: 4 DEPTH OF COMPLETED WELL: 103 ft. ELEVATION:

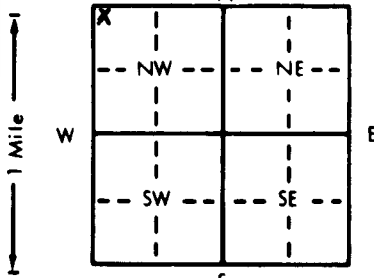

Depth(s) Groundwater Encountered 1. 6.7 ft. 2. 8.2 ft. 3. 12-6-88 ft.
 WELL'S STATIC WATER LEVEL 6.7 ft. below land surface measured on mo/day/yr 12-6-88
 Pump test data: Well water was 8.2 ft. after 2.4 hours pumping 2.2 gpm
 Est. Yield 4.0 gpm: Well water was 8.2 ft. after 2.4 hours pumping 2.2 gpm
 Bore Hole Diameter 8 in. to 10.3 ft., and 10.3 in. to 10.3 ft.
 WELL WATER TO BE USED AS:
 5 Public water supply 8 Air conditioning 11 Injection well
 1 Domestic 3 Feedlot 6 Oil field water supply 9 Dewatering 12 Other (Specify below)
2 Irrigation 4 Industrial 7 Lawn and garden only 10 Observation well
CAR WASH
 Was a chemical/bacteriological sample submitted to Department? Yes No X; If yes, mo/day/yr sample was submitted
 Water Well Disinfected? Yes X No

5 TYPE OF BLANK CASING USED:
 1 Steel 3 RMP (SR) 5 Wrought iron 8 Concrete tile CASING JOINTS: Glued X Clamped
2 PVC 4 ABS 6 Asbestos-Cement 9 Other (specify below) Welded
 7 Fiberglass Threaded
 Blank casing diameter 5 in. to 8.3 ft., Dia 8.3 in. to 8.3 ft., Dia 8.3 in. to 8.3 ft.
 Casing height above land surface 1.8 in., weight 2.843 lbs./ft. Wall thickness or gauge No. 0.265

TYPE OF SCREEN OR PERFORATION MATERIAL:
 1 Steel 3 Stainless steel 5 Fiberglass 7 PVC 10 Asbestos-cement
 2 Brass 4 Galvanized steel 6 Concrete tile 8 RMP (SR) 11 Other (specify)
 9 ABS 12 None used (open hole)

SCREEN OR PERFORATION OPENINGS ARE:
 1 Continuous slot 3 Mill slot 5 Gauzed wrapped 8 Saw cut 11 None (open hole)
 2 Louvered shutter 4 Key punched 6 Wire wrapped 9 Drilled holes
 7 Torch cut 10 Other (specify)

SCREEN-PERFORATED INTERVALS: From 8.3 ft. to 10.3 ft., From 8.3 ft. to 10.3 ft.
 GRAVEL PACK INTERVALS: From 7.0 ft. to 10.3 ft., From 7.0 ft. to 10.3 ft.

6 GROUT MATERIAL: 1 Neat cement 2 Cement grout 3 Bentonite 4 Other
 Grout Intervals: From 8.3 ft. to 10.3 ft., From 8.3 ft. to 10.3 ft.

What is the nearest source of possible contamination:
 1 Septic tank 4 Lateral lines 7 Pit privy 10 Livestock pens 14 Abandoned water well
 2 Sewer lines 5 Cess pool 8 Sewage lagoon 11 Fuel storage 15 Oil well/Gas well
 3 Watertight sewer lines 6 Seepage pit 9 Feedyard 12 Fertilizer storage 16 Other (specify below)
13 Insecticide storage NONE

Direction from well? How many feet?

FROM	TO	LITHOLOGIC LOG	FROM	TO	LITHOLOGIC LOG
0	6	top soil	92	93	shale gray
6	11	clay gray	93	97.5	LS h gray
11	16	silty clay Br	97.5	103	shale gray
16	40.5	sandy clay Br	103	104	LS gray
40.5	41.5	sand Br VF-C			
41.5	44	sandy clay Br			
44	48.5	sand Br VF-C			
48.5	61	sandy clay gray			
61	66	sand Br VF-C some boulders			
66	69	sandy clay Br			
69	70	sand Br VF-C			
70	78	sandy clay gray			
78	83	LS h gray			
83	91	shale olive			
91	92	shale red			

7 CONTRACTOR'S OR LANDOWNER'S CERTIFICATION: This water well was (1) constructed, (2) reconstructed, or (3) plugged under my jurisdiction and was completed on (mo/day/year) 12-6-88 and this record is true to the best of my knowledge and belief. Kansas
 Water Well Contractor's License No. 308 This Water Well Record was completed on (mo/day/yr) 12-6-88
 under the business name of Bieschke Drilling Co by (signature) Ray Bieschke

INSTRUCTIONS: Use typewriter or ball point pen. PLEASE PRESS FIRMLY and PRINT clearly. Please fill in blanks, underline or circle the correct answers. Send top three copies to Kansas Department of Health and Environment, Bureau of Water Protection, Topeka, Kansas 66620-7320, Telephone: 913-862-9360. Send one to WATER WELL OWNER and retain one for your records.