


1 LOCATION OF WATER WELL: County: BROWN	Fraction SW 1/4 SW 1/4 SW 1/4	Section Number 11	Township Number T 2 S	Range Number R 15 EW
---------------------------------------------------	-----------------------------------------	-----------------------------	---------------------------------	---

Distance and direction from nearest town or city street address of well if located within city?
1/2 west, 3 north of Fairview

2 WATER WELL OWNER: **Vernon Wikle**
 RR#, St. Address, Box # : **361 Parkview Drive**
 City, State, ZIP Code : **Sabetha, KS 66534**
 Board of Agriculture, Division of Water Resources
 Application Number:

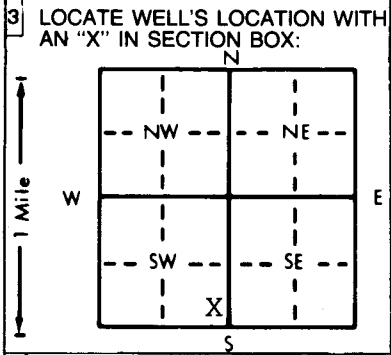

4 DEPTH OF COMPLETED WELL **120'** ft. ELEVATION:

Depth(s) Groundwater Encountered 1. **90'** ft. 2. ft. 3. ft.

WELL'S STATIC WATER LEVEL **70'** ft. below land surface measured on **mo/day/yr 5-30-89**

Pump test data: Well water was ft. after hours pumping gpm

Est. Yield **10** gpm: Well water was ft. after hours pumping gpm

Bore Hole Diameter **8 3/4"** in. to ft., and in. to ft.

WELL WATER TO BE USED AS:

5 Public water supply	8 Air conditioning	11 Injection well
1 Domestic	3 Feedlot	6 Oil field water supply
2 Irrigation	4 Industrial	7 Lawn and garden only
		10 Monitoring well

Was a chemical/bacteriological sample submitted to Department? Yes.....No.....**X**.....; If yes, mo/day/yr sample was submitted
 Water Well Disinfected? Yes **X** No

5 TYPE OF BLANK CASING USED:

1 Steel	3 RMP (SR)	5 Wrought iron	8 Concrete tile	CASING JOINTS: Glued X Clamped
2 PVC	4 ABS	6 Asbestos-Cement	9 Other (specify below)	Welded
		7 Fiberglass		Threaded

Blank casing diameter **5"** in. to **0-70** ft., Dia **5"** in. to **100-120** ft., Dia in. to ft.

Casing height above land surface **24"** in., weight **2.82** lbs./ft. Wall thickness or gauge No. **258**

TYPE OF SCREEN OR PERFORATION MATERIAL:

1 Steel	3 Stainless steel	5 Fiberglass	8 RMP (SR)	10 Asbestos-cement
2 Brass	4 Galvanized steel	6 Concrete tile	9 ABS	11 Other (specify)
				12 None used (open hole)

SCREEN OR PERFORATION OPENINGS ARE:

1 Continuous slot	3 Mill slot	5 Gauzed wrapped	8 Saw cut	11 None (open hole)
2 Louvered shutter	4 Key punched	6 Wire wrapped	9 Drilled holes	
		7 Torch cut	10 Other (specify)	

SCREEN-PERFORATED INTERVALS: From **70** ft. to **100** ft., From ft. to ft.

GRAVEL PACK INTERVALS: From **24** ft. to **120** ft., From ft. to ft.

6 GROUT MATERIAL: 1 Neat cement 2 Cement grout 3 Bentonite 4 Other

Grout Intervals: From **4** ft. to **24** ft., From ft. to ft., From ft. to ft.

What is the nearest source of possible contamination:

1 Septic tank	4 Lateral lines	7 Pit privy	10 Livestock pens	14 Abandoned water well
2 Sewer lines	5 Cess pool	8 Sewage lagoon	11 Fuel storage	15 Oil well/Gas well
3 Watertight sewer lines	6 Seepage pit	9 Feedyard	12 Fertilizer storage	16 Other (specify below)
			13 Insecticide storage	

Direction from well? **west** How many feet? **120'**

FROM	TO	LITHOLOGIC LOG	FROM	TO	PLUGGING INTERVALS
0	13	Clay-Brown	118	120	Limestone-Grey
13	24	Shale-Yellow			
24	26	Limestone-Yellow			
26	33	Shale-Yellow			
33	37	Limestone-Yellow			
37	47	Shale-Yellow			
47	50	Limestone-Yellow			
50	73	Shale-Yellow			
73	76	Limestone-Yellow			
76	84	Shale-Black			
84	90	Limestone-Yellow			
90	103	Shale-Grey			
103	107	Limestone-Grey			
107-118		Gyp			

7 CONTRACTOR'S OR LANDOWNER'S CERTIFICATION: This water well was (1) constructed, (2) reconstructed, or (3) plugged under my jurisdiction and was completed on (mo/day/year) **5-30-89** and this record is true to the best of my knowledge and belief. Kansas Water Well Contractor's License No. **182** This Water Well Record was completed on (mo/day/yr) **7-19-89** under the business name of **STRADER DRILLING CO., INC.** by (signature) *Dale Strader*