


1 LOCATION OF WATER WELL: County: Brown Fraction: SW 1/4 SE 1/4 SW 1/4 Section Number: 27 Township Number: T 2 S Range Number: R 15 E

Distance and direction from nearest town or city street address of well if located within city?
10' north of mwd 2 near water tower owned by Brown Co. RWD #1, City of Fairview

2 WATER WELL OWNER: Kans. Dept. Health & Environment
 RR#, St. Address, Box #: Bldg. 740, Forbes Field
 City, State, ZIP Code: Topeka, KS 66620
 Board of Agriculture, Division of Water Resources
 Application Number:

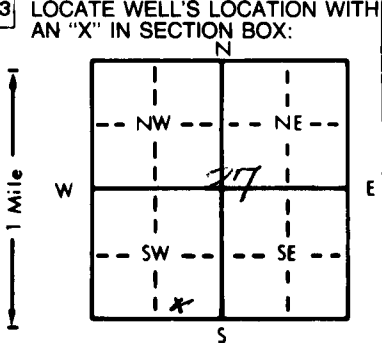

4 DEPTH OF COMPLETED WELL: 51 ft. ELEVATION: _____
 Depth(s) Groundwater Encountered: 1. _____ ft. 2. _____ ft. 3. _____ ft.
 WELL'S STATIC WATER LEVEL: None ft. below land surface measured on mo/day/yr 2/25/88
 Pump test data: Well water was _____ ft. after _____ hours pumping _____ gpm
 Est. Yield _____ gpm: Well water was _____ ft. after _____ hours pumping _____ gpm
 Bore Hole Diameter: 4 in. to 5.1 ft., and _____ in. to _____ ft.
 WELL WATER TO BE USED AS:
 5 Public water supply 8 Air conditioning 11 Injection well
 1 Domestic 3 Feedlot 6 Oil field water supply 9 Dewatering 12 Other (Specify below)
 2 Irrigation 4 Industrial 7 Lawn and garden only 10 Observation well Monitoring well
 Was a chemical/bacteriological sample submitted to Department? Yes _____ No _____; If yes, mo/day/yr sample was submitted _____
 Water Well Disinfected? Yes _____ No

5 TYPE OF BLANK CASING USED:
 1 Steel 3 RMP (SR) 5 Wrought iron 8 Concrete tile CASING JOINTS: Glued _____ Clamped _____
2 PVC 4 ABS 6 Asbestos-Cement 9 Other (specify below) Welded _____
 7 Fiberglass _____ Threaded _____
 Blank casing diameter: 2 in. to 5.1 ft., Dia _____ in. to _____ ft., Dia _____ in. to _____ ft.
 Casing height above land surface: 2.87 feet weight _____ lbs./ft. Wall thickness or gauge No. sch. 40
 TYPE OF SCREEN OR PERFORATION MATERIAL:
 1 Steel 3 Stainless steel 5 Fiberglass 8 RMP (SR) 10 Asbestos-cement
 2 Brass 4 Galvanized steel 6 Concrete tile 9 ABS 11 Other (specify) _____
 12 None used (open hole)
 SCREEN OR PERFORATION OPENINGS ARE:
 1 Continuous slot 3 Mill slot 5 Gauzed wrapped 8 Saw cut 11 None (open hole)
 2 Louvered shutter 4 Key punched 6 Wire wrapped 9 Drilled holes
 7 Torch cut 10 Other (specify) _____
 SCREEN-PERFORATED INTERVALS: From 5.1 ft. to 3.1 ft., From _____ ft. to _____ ft.
 From _____ ft. to _____ ft., From _____ ft. to _____ ft.
Sand
 GRAVEL PACK INTERVALS: From 3.1 ft. to 5.1 ft., From _____ ft. to _____ ft.
 From _____ ft. to _____ ft., From _____ ft. to _____ ft.

6 GROUT MATERIAL: 1 Neat cement 2 Cement grout 3 Bentonite 4 Other _____
 Grout Intervals: From 2.9 ft. to surface ft., From Bentonite ft., From 2.9 ft. to 3.1 ft.
 What is the nearest source of possible contamination:
 1 Septic tank 4 Lateral lines 7 Pit privy 10 Livestock pens 14 Abandoned water well
2 Sewer lines 5 Cess pool 8 Sewage lagoon 11 Fuel storage 15 Oil well/Gas well
 3 Watertight sewer lines 6 Seepage pit 9 Feedyard 12 Fertilizer storage 16 Other (specify below)
 13 Insecticide storage _____
 Direction from well? _____ How many feet? 200

FROM	TO	LITHOLOGIC LOG	FROM	TO	LITHOLOGIC LOG
0	2.0	TOPSOIL, dark gray			
2.0	3.0	Clay, silty, dark brown, damp			
3.0	6.5	Clay, greenish brown, sandy, damp			
6.5	19.5	Shale, lt. brown, with limy beds, moist			
19.5	20.5	Thin limestone beds, shaly			
20.5	21.5	Shale, tan-green, clayey			
21.5	23.5	Shale, limy, with thin limestone beds			
23.5	25.5	Shale, limy, tan			
25.5	26.5	Limestone, shaly, soft, tan			
26.5	32.5	Shale, clayey, tan to green, damp			
32.5	34.5	Limestone			
34.5	43.5	Shale, clayey, green, with occ. thin beds			
43.5	46.5	Soft limestone, shaly, somewhat beds			
46.5	51.0	Shale, tan-green, firm, somewhat limy			
	51.0	T.D.			

7 CONTRACTOR'S OR LANDOWNER'S CERTIFICATION: This water well was (1) constructed, (2) reconstructed, or (3) plugged under my jurisdiction and was completed on (mo/day/year) 2/10/88 and this record is true to the best of my knowledge and belief. Kansas Water Well Contractor's License No. _____ This Water Well Record was completed on (mo/day/yr) 2/12/88 under the business name of KDHE by (signature) Walter W. Stoltz