


1 LOCATION OF WATER WELL: Fraction SW 1/4 SE 1/4 SW 1/4 Section Number 27 Township Number T 2 S Range Number R 15 E

Distance and direction from nearest town or city street address of well if located within city?
Near water tower owned by Brown County RWD #1 in city of Fairview

2 WATER WELL OWNER: Kansas Dept. of Health & Environment
RR#, St. Address, Box #: Bldg. 740, Forbes Field
City, State, ZIP Code: Topeka, Kansas 66620
Board of Agriculture, Division of Water Resources
Application Number:

3 LOCATE WELL'S LOCATION WITH AN "X" IN SECTION BOX:

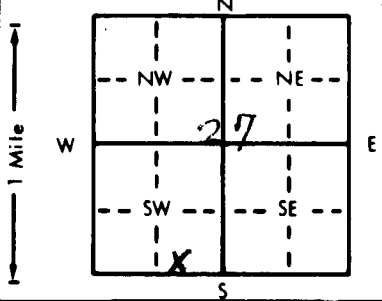

4 DEPTH OF COMPLETED WELL: 85.2 ft. ELEVATION:

Depth(s) Groundwater Encountered 1. ft. 2. ft. 3. ft.
WELL'S STATIC WATER LEVEL: 75.19 ft. below land surface measured on mo/day/yr 2/25/88
Pump test data: Well water was ft. after hours pumping gpm
Est. Yield gpm: Well water was ft. after hours pumping gpm
Bore Hole Diameter: 6 in. to 6 ft., and 4 in. to 8.5.2 ft.
WELL WATER TO BE USED AS:
1 Domestic 3 Feedlot 6 Oil field water supply 9 Dewatering 12 Other (Specify below) Monitoring well
2 Irrigation 4 Industrial 7 Lawn and garden only 10 Observation well
Was a chemical/bacteriological sample submitted to Department? Yes.....No.....; If yes, mo/day/yr sample was submitted
Water Well Disinfected? Yes No

5 TYPE OF BLANK CASING USED:
1 Steel 3 RMP (SR) 5 Wrought iron 8 Concrete tile CASING JOINTS: Glued Clamped
2 PVC 4 ABS 6 Asbestos-Cement 9 Other (specify below) Welded
7 Fiberglass Threaded

Blank casing diameter: 2 in. to 8.5 ft. Dia. in. to ft. Dia. in. to ft.
Casing height above land surface: 2.56 ft. Weight lbs./ft. Wall thickness or gauge No. Schedule 40

TYPE OF SCREEN OR PERFORATION MATERIAL:
1 Steel 3 Stainless steel 5 Fiberglass 7 PVC 10 Asbestos-cement
2 Brass 4 Galvanized steel 6 Concrete tile 8 RMP (SR) 11 Other (specify)
9 ABS 12 None used (open hole)

SCREEN OR PERFORATION OPENINGS ARE:
1 Continuous slot 3 Mill slot 5 Gauzed wrapped 8 Saw cut 11 None (open hole)
2 Louvered shutter 4 Key punched 6 Wire wrapped 9 Drilled holes
7 Torch cut 10 Other (specify)

SCREEN-PERFORATED INTERVALS: From 7.5 ft. to 8.5 ft. From ft. to ft.
From ft. to ft. From ft. to ft.
SPACER PACK INTERVALS: From 7.4 ft. to 8.5 ft. From ft. to ft.
From ft. to ft. From ft. to ft.

6 GROUT MATERIAL: 1 Neat cement 2 Cement grout 3 Bentonite 4 Other
Grout Intervals: From 0 ft. to 70 ft. From Bentonite 70 ft. to 74 ft.

What is the nearest source of possible contamination:
1 Septic tank 4 Lateral lines 7 Pit privy 10 Livestock pens 14 Abandoned water well
2 Sewer lines 5 Cess pool 8 Sewage lagoon 11 Fuel storage 15 Oil well/Gas well
3 Watertight sewer lines 6 Seepage pit 9 Feedyard 12 Fertilizer storage 16 Other (specify below)
13 Insecticide storage

Direction from well? How many feet? 200

FROM	TO	LITHOLOGIC LOG	FROM	TO	LITHOLOGIC LOG
0.0	2.0	Soil, dark gray	66.1	70.1	Limestone, fairly hard
2.0	15.0	clay, silty, dark brown	70.1	79.0	shale, grey, with some black shale
15.0	20.0	silty clay, reddish-brown	79.0	85.2	limestone, hard
20.0	30.0	shale, tan-green, limy, moist			
30.0	32.0	shale, green, damp			
32.0	33.5	limestone, soft	85.2		Total Depth
33.5	50.0	shale, grey, damp. some iron-stained zones are wet.			
50.0	53.5	limy shale or limestone with shale partings			
53.5	54.0	shale			
54.0	55.5	limestone			
55.5	64.0	shale, greenish-grey, with red			
64.0	64.8	limy shale, red			
64.8	65.3	limestone			
65.3	66.1	shale, limy, red to light grey			

7 CONTRACTOR'S OR LANDOWNER'S CERTIFICATION: This water well was (1) constructed, (2) reconstructed, or (3) plugged under my jurisdiction and was completed on (mo/day/year) 2/21/88 and this record is true to the best of my knowledge and belief. Kansas Water Well Contractor's License No. This Water Well Record was completed on (mo/day/yr) 2/15/88 under the business name of KDHE by (signature) Man W. Blottach