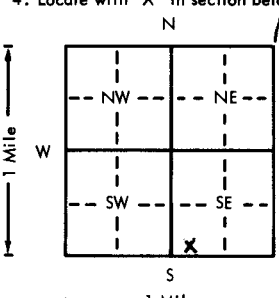
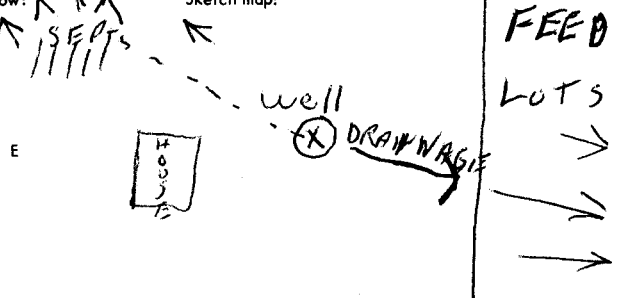


USE TYPEWRITER OR BALL
POINT PEN-PRESS FIRMLY,
PRINT CLEARLY.

WATER WELL RECORD
KSA 82a-1201-1215

Kansas Department of Health and
Environment-Division of Environment
(Water well Contractors)
Topeka, Kansas 66620

DCC

1. Location of well:	County BROWN	Fraction SW 1/4 SW 1/4 SE 1/4	Section number 33	Township number T 2	Range number S R 15	EW
2. Distance and direction from nearest town or city: 1/2 MILE WEST (FAIRVIEW)	3. Owner of well: Roger Chadwell R.R. or street: RR. 1 City, state, zip code: FAIRVIEW, KS.					
4. Locate with "X" in section below:	Sketch map:					
						
5. Type and color of material	From	To				
Top Soil	0	3				
Br. Clay	3	14				
White lime	14	19				
Hard Lime	19	22				
Gray Sandy Clay	22	26				
Lime	26	30				
Sandy Gray Clay	30	38				
Red Clay	38	39				
Gray Clay	39	45				
Lime	45	46				
Red Clay	46	60				
Soft Lime (white)	60	70				
Lime	70	81				
Blue Clay	81	84				
Lime	84	96				
Shale	96	120				
(Use a second sheet if needed)						
18. Elevation: 1205	19. Remarks: I WILL PUT MY OWN CEMENT SLAB AROUND THE WELL Roger Chadwell		20. Water well contractor's certification: This well was drilled under my jurisdiction and this report is true to the best of my knowledge and belief. STRADES DRILLING CO INC License No. 182 Business name RTI Hutton, KANSAS Address Dale Ashburn Date 6-18-76 Signed Dale Ashburn Authorized representative			

Forward the white, blue and pink copies to the Department of Health and Environment

Form WWC-5

BR = 1191

1149