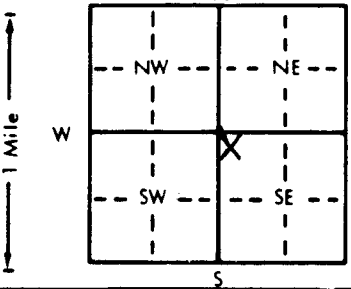


1 LOCATION OF WATER WELL: County: <b>Brown</b>		Fraction <b>NW 1/4 NW 1/4 SE 1/4</b>	Section Number <b>34</b>	Township Number <b>T 2 S</b>	Range Number <b>R 15 E</b>
Distance and direction from nearest town or city street address of well if located within city? <b>City Park</b>					
2 WATER WELL OWNER: RR#, St. Address, Box # : City, State, ZIP Code :		<b>KDHE-BER</b> <b>Building 740, Forbes Field</b> <b>Topeka, Kansas 66620</b>			
		Board of Agriculture, Division of Water Resources Application Number: <b>1204</b>			
3 LOCATE WELL'S LOCATION WITH AN "X" IN SECTION BOX: <div style="text-align: center;"></div>		4 DEPTH OF COMPLETED WELL: <b>64</b> ft. ELEVATION: <b>1204</b> Depth(s) Groundwater Encountered 1. <b>48.3</b> ft. <b>10</b> Monitoring well Was a chemical/bacteriological sample submitted to Department? Yes <b>NA</b> No <b>X</b> ; If yes, mo/day/yr sample was submitted <b>NA</b> Water Well Disinfected? Yes <b>NA</b> No <b>X</b>			
Louvered shutter 4 Key punched 6 Wire wrapped 9 Drilled holes 7 Torch cut 10 Other (specify) <b>Q</b> PVC 12 None used (open hole) SCREEN-PERFORATED INTERVALS: From <b>34</b> ft. to <b>64</b> ft., GRAVEL PACK INTERVALS: From <b>32.5</b> ft. to <b>64</b> ft., 
storage 350 Direction from well? <b>Northeast</b> How many feet? <b>350</b>					
FROM	TO	LITHOLOGIC LOG	FROM	TO	PLUGGING INTERVALS
0	6	Clay, Dark to Medium Brown			MW4I
6	13	Clay, Light to Medium Brown			GeoCore # 114085 Above-ground Cover
13	17	Limestone, Light Brown Gray			KDHE # 04007074 Tag # 00112477
17	21	Shale, Light Green to Gray Green			
21	27	Shale, Gray Green, interbedded with Red			
27	36	Shale, Red Brown			
36	40	Limestone, Gray Brown			
40	43	Shale, Dark Gray			
43	45.5	Shale, Medium Gray Brown			
45.5	50	Shale, Very Dark Gray to Black			
50	53	Limestone, Gray Brown			
53	63	Interbedded Limestone and Shale, Gray			
63	64	Shale, Dark to Medium Gray			
7 CONTRACTOR'S OR LANDOWNER'S CERTIFICATION: This water well was <b>Q</b> constructed, (2) reconstructed, or (3) plugged under my jurisdiction and was completed on (mo/day/year) <b>11/3/94</b> and this record is true to the best of my knowledge and belief. Kansas Water Well Contractor's License No. <b>527</b> This Water Well Record was completed on (mo/day/yr) <b>11/3/94</b> under the business name of <b>GeoCore Services, Inc.</b> by (signature) <b>Bob Lobb</b>					