

1 LOCATION OF WATER WELL:	Fraction	Section Number	Township Number	Range Number
County: Brown	NW 1/4 NW 1/4 SE 1/4	34	T 2 S	R 15 E E/W

Distance and direction from nearest town or city street address of well if located within city?


City Park

2 WATER WELL OWNER:	KDHE-BER
RR#, St. Address, Box # :	Building 740, Forbes Field
City, State, ZIP Code :	Topeka, Kansas 66620

Board of Agriculture, Division of Water Resources

Application Number:

3 LOCATE WELL'S LOCATION WITH AN "X" IN SECTION BOX:	4 DEPTH OF COMPLETED WELL: 87 ft. ELEVATION: 1219
--	---

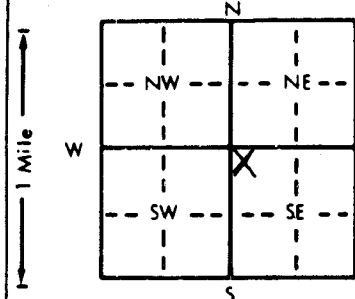

Depth(s) Groundwater Encountered 1. ft. 2. ft. 3. ft.

WELL'S STATIC WATER LEVEL **48.4** ft. below land surface measured on mo/day/yr **11/3/93**

Pump test data: Well water was ft. after hours pumping gpm

Est. Yield **NA** gpm: Well water was ft. after hours pumping gpmBore Hole Diameter **8** in. to **90** ft., and in. to ft.

WELL WATER TO BE USED AS: 5 Public water supply 8 Air conditioning 11 Injection well

1 Domestic 3 Feedlot 6 Oil field water supply 9 Dewatering 12 Other (Specify below)

2 Irrigation 4 Industrial 7 Lawn and garden only 10 Monitoring well

Was a chemical/bacteriological sample submitted to Department? Yes No **X**; If yes, mo/day/yr sample was submitted Water Well Disinfected? Yes No **X**

5 TYPE OF BLANK CASING USED:	5 Wrought iron	8 Concrete tile	CASING JOINTS: Glued Clamped
1 Steel	3 RMP (SR)	6 Asbestos-Cement	9 Other (specify below)
2 PVC	4 ABS	7 Fiberglass	Welded X
			Threaded

Blank casing diameter **4** in. to **67** ft., Dia in. to ft., Dia in. to ft.Casing height above land surface **30.1** in., weight lbs./ft. Wall thickness or gauge No. **Sch. 40**

TYPE OF SCREEN OR PERFORATION MATERIAL:	2 PVC	10 Asbestos-cement
1 Steel	3 Stainless steel	5 Fiberglass
2 Brass	4 Galvanized steel	6 Concrete tile
		8 RMP (SR)
		9 ABS
		11 Other (specify)
		12 None used (open hole)

SCREEN OR PERFORATION OPENINGS ARE: 5 Gauzed wrapped 8 Saw cut 11 None (open hole)

1 Continuous slot **3** Mill slot 6 Wire wrapped 9 Drilled holes

2 Louvered shutter 4 Key punched 7 Torch cut 10 Other (specify)

SCREEN-PERFORATED INTERVALS: From **67** ft. to **87** ft., From ft. to ft.

From ft. to ft., From ft. to ft.

GRAVEL PACK INTERVALS: From **66** ft. to **90** ft., From ft. to ft.

From ft. to ft., From ft. to ft.

6 GROUT MATERIAL:	1 Neat cement	2 Cement grout	3 Bentonite	4 Other
Grout Intervals: From 0 ft. to 33 ft., From 33 ft. to 66 ft., From ft. to ft.				

What is the nearest source of possible contamination:

1 Septic tank 4 Lateral lines 7 Pit privy 10 Livestock pens 14 Abandoned water well

2 Sewer lines 5 Cess pool 8 Sewage lagoon 11 Fuel storage 15 Oil well/Gas well

3 Watertight sewer lines 6 Seepage pit 9 Feedyard 12 Fertilizer storage **1** Other (specify below)13 Insecticide storage **UST**Direction from well? **Northeast** How many feet? **350**

FROM	TO	LITHOLOGIC LOG	FROM	TO	PLUGGING INTERVALS
0	7	Clay, Dark to Medium Brown			GeoCore # 114085
7	13	Clay, Light to Medium Brown			04007074
13	17	Limestone, Light Brown Gray			MW4D
17	21	Shale, Gray Green			Above-ground Cover
21	29	Shale, Gray Green			
29	35	Shale, Red Brown	57	63	Shale, Yellow Brown
35	41	Limestone, Gray Brown	63	67	Shale, Medium to Dark Gray
41	43	Shale, Very Dark Gray	67	71	Limestone, Medium Gray Brown
43	46	Limestone, Gray Brown	71	88	Shale, Medium Gray to Gray Green
46	51	Shale, Very Dark Brown to Black	88	90	Shale, Medium Brown Red
51	53	Limestone, Gray Brown			
53	56	Shale, Gray Brown			
56	57	Limestone, Tan to Brown Gray			

7 CONTRACTOR'S OR LANDOWNER'S CERTIFICATION: This water well was (1) constructed, (2) reconstructed, or (3) plugged under my jurisdiction and was completed on (mo/day/year) 11/3/94 and this record is true to the best of my knowledge and belief. Kansas

Water Well Contractor's License No. **527** This Water Well Record was completed on (mo/day/yr) **11/15/94**under the business name of **GeoCore Services, Inc.** by (signature) *Robt. Robt.*