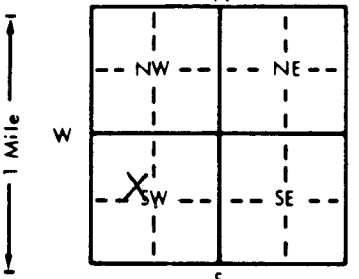


1 LOCATION OF WATER WELL: County: **Brown** Fraction **SE** $\frac{1}{4}$ **NW** $\frac{1}{4}$ **SW** $\frac{1}{4}$ Section Number **27** Township Number **T 2 S** Range Number **R 15 E** E/W

Distance and direction from nearest town or city street address of well if located within city?
North of Feedlot

2 WATER WELL OWNER: **KDHE-BER**
 RR#, St. Address, Box #: **Building 740, Forbes Field**
 City, State, ZIP Code: **Topeka, Kansas 66620**
 Board of Agriculture, Division of Water Resources
 Application Number: **1221**

3 LOCATE WELL'S LOCATION WITH AN "X" IN SECTION BOX:

 4 DEPTH OF COMPLETED WELL: **94** ft. ELEVATION: **1221**
 Depth(s) Groundwater Encountered 1. **73.7** ft. 2. _____ ft. 3. **11/3/94** ft.
 WELL'S STATIC WATER LEVEL _____ ft. below land surface measured on mo/day/yr _____
 Pump test data: Well water was _____ ft. after _____ hours pumping _____ gpm
 Est. Yield **NA** gpm; Well water was _____ ft. after _____ hours pumping _____ gpm
 Bore Hole Diameter: **8** in. to **96** ft., and _____ in. to _____ ft.
 WELL WATER TO BE USED AS:
 5 Public water supply 8 Air conditioning 11 Injection well
 1 Domestic 3 Feedlot 6 Oil field water supply 9 Dewatering 12 Other (Specify below)
 2 Irrigation 4 Industrial 7 Lawn and garden only **10** Monitoring well _____
 Was a chemical/bacteriological sample submitted to Department? Yes _____ No **X**; If yes, mo/day/yr sample was submitted _____
 Water Well Disinfected? Yes _____ No **X**

5 TYPE OF BLANK CASING USED:
 Steel 3 RMP (SR) 5 Wrought iron 8 Concrete tile CASING JOINTS: Glued _____ Clamped _____
 PVC 4 ABS 6 Asbestos-Cement 9 Other (specify below) Welded _____
 7 Fiberglass _____ Threaded **X**
 Blank casing diameter **4** in. to **64** ft., Dia _____ in. to _____ ft., Dia _____ in. to _____ ft.
 Casing height above land surface **13.9** in., weight _____ lbs./ft. Wall thickness or gauge No. **Sch. 40**
 TYPE OF SCREEN OR PERFORATION MATERIAL:
 Steel 3 Stainless steel 5 Fiberglass 8 RMP (SR) 10 Asbestos-cement
 Brass 4 Galvanized steel 6 Concrete tile 9 ABS 11 Other (specify) _____
 12 None used (open hole)
 SCREEN OR PERFORATION OPENINGS ARE:
 1 Continuous slot 2 Mill slot 5 Gauzed wrapped 8 Saw cut 11 None (open hole)
 2 Louvered shutter 4 Key punched 6 Wire wrapped 9 Drilled holes
 7 Torch cut 10 Other (specify) _____
 SCREEN-PERFORATED INTERVALS: From **64** ft. to **94** ft., From _____ ft. to _____ ft.
 GRAVEL PACK INTERVALS: From **62** ft. to **96** ft., From _____ ft. to _____ ft.

6 GROUT MATERIAL: Neat cement Cement grout Bentonite 4 Other _____
 Grout Intervals: From **0** ft. to **18** ft., From **18** ft. to **62** ft., From _____ ft. to _____ ft.
 What is the nearest source of possible contamination:
 1 Septic tank 4 Lateral lines 7 Pit privy 10 Livestock pens 14 Abandoned water well
 2 Sewer lines 5 Cess pool 8 Sewage lagoon 11 Fuel storage 15 Oil well/Gas well
 3 Watertight sewer lines 6 Seepage pit 9 Feedyard 12 Fertilizer storage **16** Other (specify below) **UST**
 13 Insecticide storage _____
 Direction from well? **0** How many feet? **0**

FROM	TO	LITHOLOGIC LOG	FROM	TO	PLUGGING INTERVALS
0	4	Clay, Medium Brown to Red Brown			MW101
4	16	Clay, Red Brown			GeoCore # 114085 Above-ground Cover
16	19	Clay, Light Brown to Yellow Brown			KDHE # 04007074 Tag # 00112422
19	27	Limestone, Light Brown			
27	29	Shale, Light Medium Brown			
29	36	Shale, Green			
36	39	Shale, Green			
39	43	Shale, Green to Gray Green			
43	52	Shale, Green, Red, Maroon			
52	59	Shale, Red to Maroon			
59	67	Shale, Red Brown			
67	76	Limestone, Light Brown			
76	81.5	Shale, Dark Gray to Black			
81.5	94	Limestone and Shale interbedded,			
94	96	Shale, Dark Medium Gray			

7 CONTRACTOR'S OR LANDOWNER'S CERTIFICATION: This water well was (1) constructed, (2) reconstructed, or (3) plugged under my jurisdiction and was completed on (mo/day/year) **11/3/94** and this record is true to the best of my knowledge and belief. Kansas Water Well Contractor's License No. **527** This Water Well Record was completed on (mo/day/yr) **12/2/94** under the business name of **GeoCore Services, Inc.** by (signature) *Paul Robb*