


1 LOCATION OF WATER WELL: County: **Brown** Fraction: **SE** $\frac{1}{4}$ **NW** $\frac{1}{4}$ **SW** $\frac{1}{4}$ Section Number: **27** Township Number: **T 2 S** Range Number: **R 15 E** E/W

Distance and direction from nearest town or city street address of well if located within city?

North of Feedlot

2 WATER WELL OWNER: **KDHE-BER**
 RR#, St. Address, Box #: **Building 740, Forbes Field**
 City, State, ZIP Code: **Topeka, Kansas 66620**
 Board of Agriculture, Division of Water Resources
 Application Number: **1222**

3 LOCATE WELL'S LOCATION WITH AN "X" IN SECTION BOX:

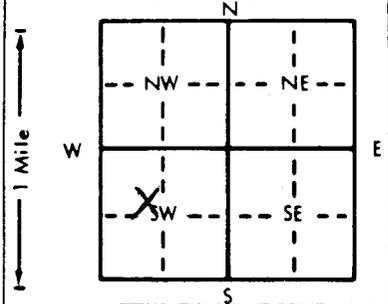

4 DEPTH OF COMPLETED WELL: **38** ft. ELEVATION: **1222**
 Depth(s) Groundwater Encountered 1. **25.5** ft. 2. ft. 3. **11/4/94** ft.
 WELL'S STATIC WATER LEVEL: ft. below land surface measured on mo/day/yr
 Pump test data: Well water was ft. after hours pumping gpm
 Est. Yield **NA** gpm: Well water was ft. after hours pumping gpm
 Bore Hole Diameter: **8** in. to **38** ft., and in. to ft.
 WELL WATER TO BE USED AS:
 5 Public water supply 8 Air conditioning 11 Injection well
 1 Domestic 3 Feedlot 6 Oil field water supply 9 Dewatering 12 Other (Specify below)
 2 Irrigation 4 Industrial 7 Lawn and garden only **10** Monitoring well
 Was a chemical/bacteriological sample submitted to Department? Yes No **X**; If yes, mo/day/yr sample was submitted
 Water Well Disinfected? Yes No **X**

5 TYPE OF BLANK CASING USED:
 Steel 3 RMP (SR) 5 Wrought iron 8 Concrete tile CASING JOINTS: Glued Clamped
 PVC 4 ABS 6 Asbestos-Cement 9 Other (specify below) Welded
 7 Fiberglass Threaded **X**
 Blank casing diameter: **2** in. to **23** ft., Dia. in. to ft., Dia. in. to ft. Sch. **40**
 Casing height above land surface: **22.1** in., weight lbs./ft. Wall thickness or gauge No.
 TYPE OF SCREEN OR PERFORATION MATERIAL:
 PVC 10 Asbestos-cement
 1 Steel 3 Stainless steel 5 Fiberglass 8 RMP (SR) 11 Other (specify)
 2 Brass 4 Galvanized steel 6 Concrete tile 9 ABS 12 None used (open hole)
 SCREEN OR PERFORATION OPENINGS ARE:
 Mill slot 5 Gauzed wrapped 8 Saw cut 11 None (open hole)
 1 Continuous slot 6 Wire wrapped 9 Drilled holes
 2 Louvered shutter 4 Key punched 7 Torch cut 10 Other (specify)
 SCREEN-PERFORATED INTERVALS: From **23** ft. to **38** ft., From ft. to ft.
 From ft. to ft., From ft. to ft.
 GRAVEL PACK INTERVALS: From **20** ft. to **38** ft., From ft. to ft.
 From ft. to ft., From ft. to ft.

6 GROUT MATERIAL: Neat cement Cement grout Bentonite 4 Other
 Grout Intervals: From **0** ft. to **5** ft., From **5** ft. to **20** ft., From ft. to ft.
 What is the nearest source of possible contamination:
 1 Septic tank 4 Lateral lines 7 Pit privy 10 Livestock pens 14 Abandoned water well
 2 Sewer lines 5 Cess pool 8 Sewage lagoon 11 Fuel storage 15 Oil well/Gas well
 3 Watertight sewer lines 6 Seepage pit 9 Feedyard 12 Fertilizer storage **16** Other (specify below) **UST**
 13 Insecticide storage
 Direction from well? **0** How many feet? **0**

FROM	TO	LITHOLOGIC LOG	FROM	TO	PLUGGING INTERVALS
0	9	Clay, Medium Red Brown			MW10S
9	15	Clay, Medium Brown Red			GeoCore # 114085 Above-ground Cover
15	17	Clay, Light Brown			KDHE # 04007074 Tag # 00112439
17	18	Clay, Medium Green Brown			
18	22	Clay, Medium Light Brown			
22	26	Limestone, Light Brown Gray			
26	34	Shale, Yellow to Yellow Green			
34	38	Limestone, Light Gray to Brown Gray			

7 CONTRACTOR'S OR LANDOWNER'S CERTIFICATION: This water well was **1** constructed, (2) reconstructed, or (3) plugged under my jurisdiction and was completed on (mo/day/year) **11/3/94** and this record is true to the best of my knowledge and belief. Kansas Water Well Contractor's License No. **527**
 This Water Well Record was completed on (mo/day/yr) **12/2/94**
 under the business name of **GeoCore Services, Inc.** by (signature) *Paul Robb*