


1 LOCATION OF WATER WELL: Fraction SE 1/4 S.E. 1/4 S.E. 1/4 Section Number 23 Township Number T 2 South S Range Number R 16 EW

Distance and direction from nearest town or city street address of well if located within city?
2 mi west of 12th & Miami, Hiawatha, KS 66434

2 WATER WELL OWNER: Russell Stover
 RR#, St. Address, Box #: RR 3 Board of Agriculture, Division of Water Resources
 City, State, ZIP Code: Hiawatha, KS 66434 Application Number:

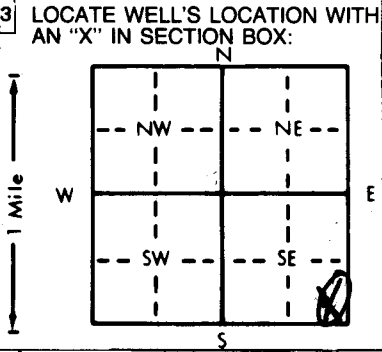

4 DEPTH OF COMPLETED WELL: 36 ft. ELEVATION: 10-20-89
 Depth(s) Groundwater Encountered 1. 24 ft. 2. ft. 3. ft.
 WELL'S STATIC WATER LEVEL: 20 ft. below land surface measured on mo/day/yr
 Pump test data: Well water was 30 ft. after 4 hours pumping 3 gpm
 Est. Yield 1 gpm: Well water was ft. after hours pumping gpm
 Bore Hole Diameter: 54 in. to 20 ft., and 42 in. to 36 ft.
 WELL WATER TO BE USED AS:
 1 Domestic 3 Feedlot 6 Oil field water supply 9 Dewatering 12 Other (Specify below)
 2 Irrigation 4 Industrial 7 Lawn and garden only 10 Monitoring well
 Was a chemical/bacteriological sample submitted to Department? Yes No If yes, mo/day/yr sample was submitted
 Water Well Disinfected? Yes No

5 TYPE OF BLANK CASING USED:
 1 Steel 3 RMP (SR) 5 Wrought iron 8 Concrete tile CASING JOINTS: Glued Clamped
 2 PVC 4 ABS 6 Asbestos-Cement 9 Other (specify below) Welded
 7 Fiberglass Threaded
 Blank casing diameter 36 in. to 36 ft., Dia. in. to ft., Dia. in. to ft.
 Casing height above land surface 36 in., weight 320 lbs/ft lbs./ft. Wall thickness or gauge No. 3"
 TYPE OF SCREEN OR PERFORATION MATERIAL:
 1 Steel 3 Stainless steel 5 Fiberglass 8 RMP (SR) 11 Other (specify)
 2 Brass 4 Galvanized steel 6 Concrete tile 9 ABS 2 None used (open hole)
 SCREEN OR PERFORATION OPENINGS ARE:
 1 Continuous slot 3 Mill slot 5 Gauzed wrapped 8 Saw cut 11 (None (open hole))
 2 Louvered shutter 4 Key punched 6 Wire wrapped 9 Drilled holes
 7 Torch cut 10 Other (specify)
 SCREEN-PERFORATED INTERVALS: From ft. to ft., From ft. to ft., From ft. to ft.
 GRAVEL PACK INTERVALS: From ft. to ft., From ft. to ft., From ft. to ft.

6 GROUT MATERIAL: 1 Neat cement 2 Cement grout 3 Bentonite 4 Other
 Grout Intervals: From ft. to ft., From ft. to ft., From ft. to ft.
 What is the nearest source of possible contamination:
 1 Septic tank 4 Lateral lines 7 Pit privy 10 Livestock pens 14 Abandoned water well
 2 Sewer lines 5 Cess pool 8 Sewage lagoon 11 Fuel storage 15 Oil well/Gas well
 3 Watertight sewer lines 6 Seepage pit 9 Feedyard 12 Fertilizer storage 16 Other (specify below)
 13 Insecticide storage
 Direction from well? SOUTH EAST How many feet? 100

FROM	TO	LITHOLOGIC LOG	FROM	TO	PLUGGING INTERVALS
0	2	Top Soil			
2	11	Silty Clay			
11	17	Yellow Clay			
17	24	Yellow Clay			
24	31	Brown Coarse Sand			
31	36	Blue Shale			

7 CONTRACTOR'S OR LANDOWNER'S CERTIFICATION: This water well was (1) constructed (2) reconstructed, or (3) plugged under my jurisdiction and was completed on (mo/day/year) 10-20-89 and this record is true to the best of my knowledge and belief. Kansas Water Well Contractor's License No. 320 This Water Well Record was completed on (mo/day/yr) 11-17-89 under the business name of POPPLEWELL WELL DRIVING by (signature) Jerry Popplewell

CR 1415 = 11-21-89