


WATER WELL RECORD Form WWC-5 KSA 82a-1212

1 LOCATION OF WATER WELL: County: Brown Fraction: SE 1/4 1/4 1/4 Section Number: 29 Township Number: T 2 S Range Number: R 17 EW

Distance and direction from nearest town or city street address of well if located within city?
800 S. 1st Street

2 WATER WELL OWNER: Flair Fold Corporation FSMW #6
 RR#, St. Address, Box # : PO Box 355 Board of Agriculture, Division of Water Resources
 City, State, ZIP Code : Hiawatha, KS 66434 Application Number: 1134-28

3 LOCATE WELL'S LOCATION WITH AN "X" IN SECTION BOX:

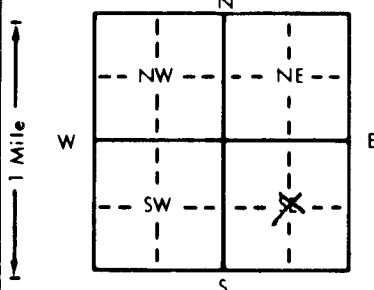

4 DEPTH OF COMPLETED WELL: 13.8 ft. ELEVATION: 1134.28

Depth(s) Groundwater Encountered: 1. 2.1 ft. 2. 2.1 ft. 3. 2.1 ft.
 WELL'S STATIC WATER LEVEL: 2.1 ft. below land surface measured on 5/26/95
 Pump test data: Well water was _____ ft. after _____ hours pumping _____ gpm
 Est. Yield _____ gpm: Well water was _____ ft. after _____ hours pumping _____ gpm
 Bore Hole Diameter: _____ in. to _____ ft., and _____ in. to _____ ft.
 WELL WATER TO BE USED AS:
 1 Domestic 2 Irrigation 3 Feedlot 4 Industrial 5 Public water supply 6 Oil field water supply 7 Lawn and garden only 8 Air conditioning 9 Dewatering 10 Monitoring well 11 Injection well 12 Other (Specify below) _____
 Was a chemical/bacteriological sample submitted to Department? Yes _____ No ; If yes, mo/day/yr sample was sub-
 mitted _____ Water Well Disinfected? Yes _____ No

5 TYPE OF BLANK CASING USED:
 1 Steel 2 PVC 3 RMP (SR) 4 ABS 5 Wrought iron 6 Asbestos-Cement 7 Fiberglass 8 Concrete tile 9 Other (specify below) _____ CASING JOINTS: Glued _____ Clamped _____ Welded _____ Threaded

Blank casing diameter: 2 in. to 3.3 ft., Dia _____ in. to _____ ft., Dia _____ in. to _____ ft.
 Casing height above land surface: 7.2 in., weight 0.10 lbs./ft. Wall thickness or gauge No. Sch 40

TYPE OF SCREEN OR PERFORATION MATERIAL:
 1 Steel 2 Brass 3 Stainless steel 4 Galvanized steel 5 Fiberglass 6 Concrete tile 7 PVC 8 RMP (SR) 9 ABS 10 Asbestos-cement 11 Other (specify) _____ 12 None used (open hole) _____

SCREEN OR PERFORATION OPENINGS ARE:
 1 Continuous slot 2 Louvered shutter 3 Mill slot 4 Key punched 5 Gauzed wrapped 6 Wire wrapped 7 Torch cut 8 Saw cut 9 Drilled holes 10 Other (specify) _____ 11 None (open hole) _____

SCREEN-PERFORATED INTERVALS: From 13.8 ft. to 3.3 ft. From _____ ft. to _____ ft.
 GRAVEL PACK INTERVALS: From 13.8 ft. to 2.5 ft. From _____ ft. to _____ ft.

6 GROUT MATERIAL: 1 Neat cement 2 Cement grout 3 Bentonite 4 Other _____
 Grout Intervals: From 2.5 ft. to 0 ft. From _____ ft. to _____ ft.

What is the nearest source of possible contamination:
 1 Septic tank 2 Sewer lines 3 Watertight sewer lines 4 Lateral lines 5 Cess pool 6 Seepage pit 7 Pit privy 8 Sewage lagoon 9 Feedyard 10 Livestock pens 11 Fuel storage 12 Fertilizer storage 13 Insecticide storage 14 Abandoned water well 15 Oil well/Gas well 16 Other (specify below) Phase II environmental Assessment

Direction from well? _____ How many feet? _____

FROM	TO	LITHOLOGIC LOG	FROM	TO	PLUGGING INTERVALS
		see attached			
0'	5'	02 Silt			
5'	9'	03 Silty Clay			
9'	9.5'	02 Silt			
9.5'	14'	03 Silty Clay			
14'	16'	01 clay			

7 CONTRACTOR'S OR LANDOWNER'S CERTIFICATION: This water well was (1) constructed, (2) reconstructed, or (3) plugged under my jurisdiction and was completed on (mo/day/year) 5/20/95 and this record is true to the best of my knowledge and belief. Kansas Water Well Contractor's License No. 102 This Water Well Record was completed on (mo/day/yr) 6-29-95 under the business name of Layne Inc by (signature) [Signature]

INSTRUCTIONS: Use typewriter or ball point pen. PLEASE PRESS FIRMLY and PRINT clearly. Please fill in blanks, underline or circle the correct answers. Send top three copies to Kansas Department of Health and Environment, Bureau of Water, Topeka, Kansas 66620-0001. Telephone: 913-296-5545. Send one to WATER WELL OWNER and retain one for your records.