


WATER WELL RECORD Form WWC-5 KSA 82a-1212

1 LOCATION OF WATER WELL: County: BROWN Fraction SW 1/4 NE 1/4 NW 1/4 Section Number 29 Township Number T 2 S Range Number R 17 E 2

Distance and direction from nearest town or city street address of well if located within city? 900 OREGON, HIAWATHA, KS MW-8

2 WATER WELL OWNER: BROWN COUNTY COOPERATIVE RR#, St. Address, Box #: 900 OREGON Board of Agriculture, Division of Water Resources City, State, ZIP Code: HIAWATHA, KS Application Number:

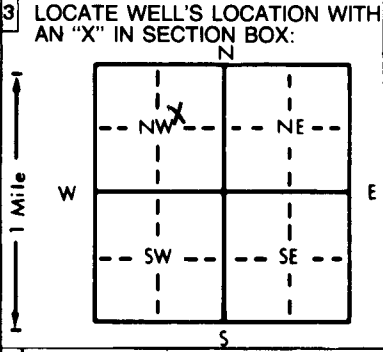

4 DEPTH OF COMPLETED WELL: 18.0 ft. ELEVATION: 1100.78 Depth(s) Groundwater Encountered 1. 10.50 ft. 2. ft. 3. ft. WELL'S STATIC WATER LEVEL: 6.44 ft. below land surface measured on mo/day/yr 11/18/96

5 TYPE OF BLANK CASING USED: 1 Steel, 2 PVC, 3 RMP (SR), 4 ABS, 5 Wrought iron, 6 Asbestos-Cement, 7 Fiberglass, 8 Concrete tile, 9 Other (specify below), 10 Asbestos-cement, 11 Other (specify), 12 None used (open hole)

6 GROUT MATERIAL: 1 Neat cement, 2 Cement grout, 3 Bentonite, 4 Other Grout Intervals: From 7 ft. to 5 ft., From 5 ft. to 1 ft., From 1 ft. to 0 ft.

Table with columns: FROM, TO, LITHOLOGIC LOG, FROM, TO, PLUGGING INTERVALS. Contains handwritten entries for 0-9' and 9-18' intervals.

7 CONTRACTOR'S OR LANDOWNER'S CERTIFICATION: This water well was 1) constructed, (2) reconstructed, or (3) plugged under my jurisdiction and was completed on (mo/day/year) 11/18/96 and this record is true to the best of my knowledge and belief. Kansas Water Well Contractor's License No. 614 This Water Well Record was completed on (mo/day/yr) 12/18/96 under the business name of Maxm/KCTL by (signature) Donald Jasso