


1 LOCATION OF WATER WELL: County: Brown Fraction: NE 1/4 NE 1/4 NE 1/4 Section Number: 9 Township Number: T 2 S Range Number: R 17 E/W

Distance and direction from nearest town or city street address of well if located within city?  
3 miles North & 1 mile East of Hiawatha, KS.

2 WATER WELL OWNER: Thomas E. Johansen  
 RR#, St. Address, Box #: Rt. 2 Box 130  
 City, State, ZIP Code: Hiawatha, KS, 66434  
 Board of Agriculture, Division of Water Resources  
 Application Number:

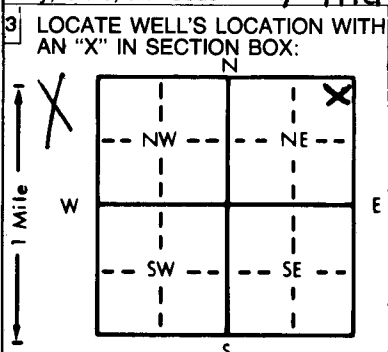

4 DEPTH OF COMPLETED WELL: 59 ft. ELEVATION: X 1148  
 Depth(s) Groundwater Encountered 1. 42 ft. 2. \_\_\_\_\_ ft. 3. \_\_\_\_\_ ft.  
 WELL'S STATIC WATER LEVEL 38 ft. below land surface measured on 7-18-89  
 Pump test data: Well water was 46 ft. after 2 hours pumping 8 gpm  
 Est. Yield 2 1/2 gpm: Well water was \_\_\_\_\_ ft. after \_\_\_\_\_ hours pumping \_\_\_\_\_ gpm  
 Bore Hole Diameter: 54 in. to 20 in. and 42 in. to 59 in.  
 WELL WATER TO BE USED AS:  
 1 Domestic  3 Feedlot  6 Oil field water supply  9 Dewatering  12 Other (Specify below)  
 2 Irrigation  4 Industrial  7 Lawn and garden only  10 Observation well  
 Was a chemical/bacteriological sample submitted to Department? Yes  No \_\_\_\_\_ If yes, mo/day/yr sample was submitted \_\_\_\_\_  
 Water Well Disinfected?  Yes  No

5 TYPE OF BLANK CASING USED:  
 1 Steel  3 RMP (SR)  5 Wrought iron  8 Concrete tile  CASING JOINTS: Glued \_\_\_\_\_ Clamped \_\_\_\_\_  
 2 PVC  4 ABS  6 Asbestos-Cement  9 Other (specify below) \_\_\_\_\_ Welded \_\_\_\_\_  
 7 Fiberglass  Threaded \_\_\_\_\_  
 Blank casing diameter 36 in. to 59 in. Dia \_\_\_\_\_ in. to \_\_\_\_\_ in. Dia \_\_\_\_\_ in. to \_\_\_\_\_ in. Dia \_\_\_\_\_  
 Casing height above land surface: 28 in., weight 320 lbs/ft. (Wall thickness or gauge 3")  
 TYPE OF SCREEN OR PERFORATION MATERIAL:  
 1 Steel  3 Stainless steel  5 Fiberglass  8 RMP (SR)  11 Other (specify) \_\_\_\_\_  
 2 Brass  4 Galvanized steel  9 ABS  12 None used (open hole)   
 SCREEN OR PERFORATION OPENINGS ARE:  
 1 Continuous slot  3 Mill slot  5 Gauzed wrapped  8 Saw cut  11 None (open hole)   
 2 Louvered shutter  4 Key punched  6 Wire wrapped  9 Drilled holes \_\_\_\_\_  
 7 Torch cut  10 Other (specify) \_\_\_\_\_  
 SCREEN-PERFORATED INTERVALS: From \_\_\_\_\_ ft. to \_\_\_\_\_ ft., From \_\_\_\_\_ ft. to \_\_\_\_\_ ft., From \_\_\_\_\_ ft. to \_\_\_\_\_ ft.  
 GRAVEL BACK INTERVALS: From \_\_\_\_\_ ft. to \_\_\_\_\_ ft., From \_\_\_\_\_ ft. to \_\_\_\_\_ ft., From \_\_\_\_\_ ft. to \_\_\_\_\_ ft.

6 GROUT MATERIAL:  1 Neat cement  2 Cement grout  3 Bentonite  4 Other \_\_\_\_\_  
 Grout Intervals: From 0 ft. to 20 ft., From \_\_\_\_\_ ft. to \_\_\_\_\_ ft., From \_\_\_\_\_ ft. to \_\_\_\_\_ ft.  
 What is the nearest source of possible contamination:  
 1 Septic tank  4 Lateral lines  7 Pit privy  10 Livestock pens  14 Abandoned water well  
 2 Sewer lines  5 Cess pool  8 Sewage lagoon  11 Fuel storage  15 Oil well/Gas well  
 3 Watertight sewer lines  6 Seepage pit  9 Feedyard  12 Fertilizer storage  16 Other (specify below) \_\_\_\_\_  
 13 Insecticide storage \_\_\_\_\_  
 Direction from well? \_\_\_\_\_ How many feet? 300'

FROM	TO	LITHOLOGIC LOG	FROM	TO	LITHOLOGIC LOG
0	2	BLACK TOPSOIL			
2	14	YELLOW WIND BLOWN			
14	42	YELLOW CLAY			
42	51	COARSE YELLOW SAND & GRAVEL PRODUCES WATER.			
51	59	HARD YELLOW CLAY			
	59	BITTOM YELLOW CLAY			

7 CONTRACTOR'S OR LANDOWNER'S CERTIFICATION: This water well was  (1) constructed, (2) reconstructed, or (3) plugged under my jurisdiction and was completed on (mo/day/year) 7-17-89 and this record is true to the best of my knowledge and belief. Kansas Water Well Contractor's License No. 320 This Water Well Record was completed on (mo/day/yr) 8-4-89 under the business name of POPPERWELL WELL BORING by (signature) Derry Popperwell

INSTRUCTIONS: Use typewriter or ball point pen, PLEASE PRESS FIRMLY and PRINT clearly. Please fill in blanks, underline or circle the correct answers. Send top three copies to Kansas Department of Health and Environment, Division of Environment, Environmental Geology Section, Topeka, KS 66620. Send one to WATER WELL OWNER and retain one for your records.