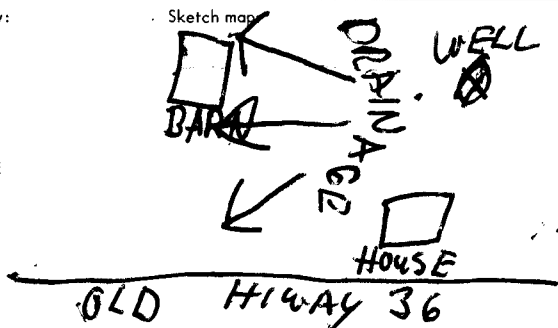


USE TYPEWRITER OR BALL POINT PEN-PRESS FIRMLY, PRINT CLEARLY.

WATER WELL RECORD
KSA 82a-1201-1215

Kansas Department of Health and Environment-Division of Environment
(Water well Contractors)
Topeka, Kansas 66620

CDD

| | | | | | |
|--|------------------------|---|---|--|---------------------------|
| 1. Location of well: | County Brown | Fracton SE 1/4 SE 1/4 SW 1/4 | Section number 21 | Township number T 2 S R 17 E W | Range number 17 |
| 2. Distance and direction from nearest town or city: 1 mile east of Hiawatha, Kansas on old Hwy. 36 Street address of well location if in city: | | | 3. Owner of well: Warren Gatz R.R. or street: R.R. 2 City, state, zip code: Hiawatha, Kansas 66341 | | |
| 4. Locate with "X" in section below: N W E S 1 Mile Sketch map:  | | | 6. Bore hole dia. 12 in. Completion date 7/10/82 Well depth 72 ft. Bore hole 50" to 11" | | |
| 5. Type and color of material | | | 7. <input type="checkbox"/> Cable tool <input type="checkbox"/> Rotary <input type="checkbox"/> Driven <input type="checkbox"/> Dug <input type="checkbox"/> Hollow rod <input type="checkbox"/> Jetted <input checked="" type="checkbox"/> Bored <input type="checkbox"/> Reverse rotary | | |
| 8. Use: <input checked="" type="checkbox"/> Domestic <input type="checkbox"/> Public supply <input type="checkbox"/> Industry <input type="checkbox"/> Irrigation <input type="checkbox"/> Air conditioning <input type="checkbox"/> Stock <input type="checkbox"/> Lawn <input type="checkbox"/> Oil field water <input type="checkbox"/> Other | | | 9. Casing: Material Concrete Height: above or below Threaded <input type="checkbox"/> Welded <input type="checkbox"/> Surface 2 1/2 in. RMP <input type="checkbox"/> PVC <input type="checkbox"/> Weight 320 lbs./ft. Dia. 36 in. to 72 ft. depth; Wall Thickness: inches or Dia. <input type="checkbox"/> in. to <input type="checkbox"/> ft. depth; gage No. 2 1/2 | | |
| 10. Screen: Manufacturer's name _____ Type _____ Dia. _____ Slot/gauze _____ Length _____ Set between _____ ft. and _____ ft. _____ ft. and _____ ft. Gravel pack? _____ Size range of material _____ | | | 11. Static water level: _____ mo./day/yr. 30 ft. below land surface Date 7/9/82 | | |
| 12. Pumping level below land surfaces: 1/8 ft. after 1 hrs. pumping 20 g.p.m. 1/8 ft. after 3 hrs. pumping 20 g.p.m. Estimated maximum yield 15 g.p.m. | | | 13. Water sample submitted: _____ mo./day/yr. <input type="checkbox"/> Yes <input checked="" type="checkbox"/> No Date _____ | | |
| 14. Well head completion: <input type="checkbox"/> Pitless adapter _____ Inches above grade | | | 15. Well grouted? <input checked="" type="checkbox"/> With: <input checked="" type="checkbox"/> Neat cement <input type="checkbox"/> Bentonite <input type="checkbox"/> Concrete Depth: From 0 ft. to 11 ft. | | |
| 16. Nearest source of possible contamination: ft. 300 Direction west Type barnlot Well disinfected upon completion? <input checked="" type="checkbox"/> Yes <input type="checkbox"/> No | | | 17. Pump: <input checked="" type="checkbox"/> Not installed Manufacturer's name _____ Model number _____ HP _____ Volts _____ Length of drop pipe _____ ft. capacity _____ g.p.m. Type: <input type="checkbox"/> Submersible <input type="checkbox"/> Turbine <input type="checkbox"/> Jet <input type="checkbox"/> Reciprocating <input type="checkbox"/> Centrifugal <input type="checkbox"/> Other | | |
| (Use a second sheet if needed) | | | 20. Water well contractor's certification: This well was drilled under my jurisdiction and this report is true to the best of my knowledge and belief. Popplewell Well Boring 320 Business name _____ License No. _____ Address Amity, Mo. 64122 Signed Jerry Popplewell Date 8/3/82 Authorized Representative | | |
| 18. Elevation: 1124 | 19. Remarks: | | 20. Water well contractor's certification: This well was drilled under my jurisdiction and this report is true to the best of my knowledge and belief. Popplewell Well Boring 320 Business name _____ License No. _____ Address Amity, Mo. 64122 Signed Jerry Popplewell Date 8/3/82 Authorized Representative | | |
| Topography: RW <input checked="" type="checkbox"/> Hill <input type="checkbox"/> Slope <input type="checkbox"/> Upland <input type="checkbox"/> Valley | | | | | |

