

34

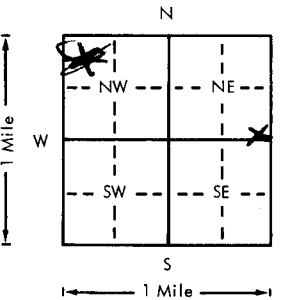
R

USE TYPEWRITER OR BALL POINT PEN-PRESS FIRMLY, PRINT CLEARLY.

WATER WELL RECORD
KSA 82a-1201-1215

Kansas Department of Health and Environment-Division of Environment
(Water well Contractors)
Topeka, Kansas 66620

SE SE NE 30

1. Location of well: County: BROWN		Fraction: NW 1/4 NW 1/4 NW 1/4		Section number: 29		Township number: T 2 S 17 R EW		Range number: 17	
2. Distance and direction from nearest town or city: FN Street address of well location if in city: HIAWATHA				3. Owner of well: WIDE TOOL CO., Inc R.R. or street: 13th + POTTAWATOMIE City, state, zip code: HIAWATHA, KS.					
4. Locate with "X" in section below: 				Sketch map: Sewer line 200' X well		6. Bore hole dia. 12 in. Completion date _____ Well depth 80 ft. 5-31-78			
5. Type and color of material				From		To		7. Cable tool <input checked="" type="checkbox"/> Rotary <input type="checkbox"/> Driven <input type="checkbox"/> Dug <input type="checkbox"/> Hollow rod <input type="checkbox"/> Jetted <input type="checkbox"/> Bored <input type="checkbox"/> Reverse rotary	
								8. Use: <input type="checkbox"/> Domestic <input type="checkbox"/> Public supply <input checked="" type="checkbox"/> Industry <input type="checkbox"/> Irrigation <input type="checkbox"/> Air conditioning <input type="checkbox"/> Stock <input type="checkbox"/> Lawn <input type="checkbox"/> Oil field water <input type="checkbox"/> Other	
								9. Casing: Material PVC Height: 60' or below Threaded <input type="checkbox"/> Welded <input type="checkbox"/> Surface 24 in. RMP <input type="checkbox"/> PVC 9L Weight 3.58 lbs./ft. Dia. 6 in. to 80 ft. depth Wall Thickness: inches or Dia. _____ in. to _____ ft. depth gage No. 1280	
								10. Screen: Manufacturer's name _____ Pumpco MPI Type PVC Dia. 6 <input checked="" type="checkbox"/> gauze 1020 Length 20 Set between 43 ft. and 63 ft. _____ ft. and _____ ft. Gravel pack? <input checked="" type="checkbox"/> Size range of material 1030x1060	
								11. Static water level: _____ mo./day/yr. 40 ft. below land surface Date 5-31-78	
								12. Pumping level below land surfaces: _____ ft. after _____ hrs. pumping _____ g.p.m. _____ ft. after _____ hrs. pumping _____ g.p.m. Estimated maximum yield 60 g.p.m.	
								13. Water sample submitted: _____ mo./day/yr. <input type="checkbox"/> Yes <input checked="" type="checkbox"/> No Date _____	
								14. Well head completion: cap <input type="checkbox"/> Pitless adapter 24 inches above grade	
								15. Well grouted? <input checked="" type="checkbox"/> With: <input checked="" type="checkbox"/> Neat cement <input type="checkbox"/> Bentonite <input type="checkbox"/> Concrete Depth: From 0 ft. to 20 ft.	
								16. Nearest source of possible contamination: ft. 200 Direction N Type Sewer line Well disinfected upon completion? <input checked="" type="checkbox"/> Yes <input type="checkbox"/> No	
								17. Pump: _____ Not installed Manufacturer's name Jacuzzi Model number 554X17 HP 5 Volts 230 Length of drop pipe 70 ft. capacity 50 g.p.m. Type: <input checked="" type="checkbox"/> Submersible <input type="checkbox"/> Turbine <input type="checkbox"/> Jet <input type="checkbox"/> Reciprocating <input type="checkbox"/> Centrifugal <input type="checkbox"/> Other	
								20. Water well contractor's certification: This well was drilled under my jurisdiction and this report is true to the best of my knowledge and belief. STANDES Dalg Co Inc 182 Business name License No. _____ Address RT 1 Holton, KS Signed Dale Robson Date 6-2-78 Authorized representative	
18. Elevation: 1125 Topography: <input checked="" type="checkbox"/> Hill 1121 <input type="checkbox"/> Slope RM <input type="checkbox"/> Upland <input type="checkbox"/> Valley		19. Remarks: well #1 we installed slab 6'x6'							

Forward the white, blue and pink copies to the Department of Health and Environment

Form WWC-5

BR = 1066
1061

▽ = 1085
1080