


1 LOCATION OF WATER WELL: County: **Brown** Fraction: **NE 1/4 NE 1/4 SE 1/4** Section Number: **29** Township Number: **T 2 S** Range Number: **R 17 E**

Distance and direction from nearest town or city, street address of well if located within city?
310 N 1st. Hiawatha, KS.

2 WATER WELL OWNER: **Ramona Scheid**
 RR#, St. Address, Box # : **310 N 1st.** Board of Agriculture, Division of Water Resources
 City, State, ZIP Code : **Hiawatha, Ks.** Application Number:

3 LOCATE WELL'S LOCATION WITH AN "X" IN SECTION BOX:

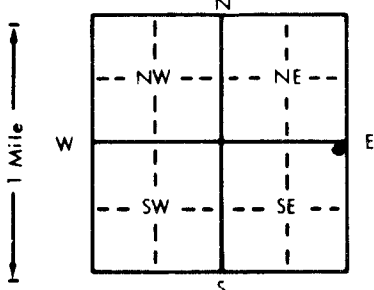

4 DEPTH OF COMPLETED WELL: **15'6"** ft. ELEVATION:

Depth(s) Groundwater Encountered **1.14'** ft. 2. ft. 3. ft.
 WELL'S STATIC WATER LEVEL **14'3"** ft. below land surface measured on mo/day/yr **7-6-94**
 Pump test data: Well water was _____ ft. after _____ hours pumping _____ gpm
 Est. Yield _____ gpm: Well water was _____ ft. after _____ hours pumping _____ gpm
 Bore Hole Diameter: **8 1/2"** in. to **15'6"** ft., and _____ in. to _____ ft.
 WELL WATER TO BE USED AS:
 5 Public water supply 8 Air conditioning 11 Injection well
 1 Domestic 3 Feedlot 6 Oil field water supply 9 Dewatering 12 Other (Specify below)
 2 Irrigation 4 Industrial 7 Lawn and garden only **10** Monitoring well
 Was a chemical/bacteriological sample submitted to Department? Yes _____ No **X**; If yes, mo/day/yr sample was sub-
 mitted _____ Water Well Disinfected? Yes _____ No **(No)**

5 TYPE OF BLANK CASING USED:
 1 Steel 3 RMP (SR) 5 Wrought iron 8 Concrete tile CASING JOINTS: Glued _____ Clamped _____
2 PVC 4 ABS 6 Asbestos-Cement 9 Other (specify below) Welded _____
 7 Fiberglass Threaded _____ **+**

Blank casing diameter **2.375** in. to **5'** ft., Dia _____ in. to _____ ft., Dia _____ in. to **SDR 13** ft.
 Casing height above land surface **Flush Mount** in., weight _____ lbs./ft. Wall thickness or gauge No. **SCH 40**

TYPE OF SCREEN OR PERFORATION MATERIAL:
 1 Steel 3 Stainless steel 5 Fiberglass 8 RMP (SR) 10 Asbestos-cement
 2 Brass 4 Galvanized steel 6 Concrete tile 9 ABS 11 Other (specify) _____
 12 None used (open hole)

SCREEN OR PERFORATION OPENINGS ARE:
 1 Continuous slot **3 Mill slot** 5 Gauzed wrapped 8 Saw cut 11 None (open hole)
 2 Louvered shutter 4 Key punched 6 Wire wrapped 9 Drilled holes
 7 Torch cut 10 Other (specify) _____

SCREEN-PERFORATED INTERVALS: From **15'** ft. to **5'** ft., From _____ ft. to _____ ft.
 From _____ ft. to _____ ft., From _____ ft. to _____ ft.
 GRAVEL PACK INTERVALS: From **15'6"** ft. to **4'** ft., From _____ ft. to _____ ft.
 From _____ ft. to _____ ft., From _____ ft. to _____ ft.

6 GROUT MATERIAL: 1 Neat cement 2 Cement grout **3 Bentonite** 4 Other
 Grout Intervals: From **4'** ft. to **3'** ft., From **3'** ft. to **0'** ft., From _____ ft. to _____ ft.

What is the nearest source of possible contamination:
 1 Septic tank 4 Lateral lines 7 Pit privy **11 Fuel storage Fower** 14 Abandoned water well
 2 Sewer lines 5 Cess pool 8 Sewage lagoon 12 Fertilizer storage 16 Other (specify below)
 3 Watertight sewer lines 6 Seepage pit 9 Feedyard 13 Insecticide storage

Direction from well? **In Old Tank Pit** How many feet? **0**

FROM	TO	LITHOLOGIC LOG	FROM	TO	PLUGGING INTERVALS
0	3.50	Med dk brn silty mottled clayfill, moist, no odor.			
3.50	9.25	Blue green silty clay, mod. odor, moist, iron oxides.			
9.25	15'6"	Med red brn silty clay, tight, stiff, mottled till, no odor, iron oxides.			

7 CONTRACTOR'S OR LANDOWNER'S CERTIFICATION: This water well was (1) **constructed** (2) reconstructed, or (3) plugged under my jurisdiction and was completed on (mo/day/year) **7-5-94** and this record is true to the best of my knowledge and belief. Kansas Water Well Contractor's License No. **539** This Water Well Record was completed on (mo/day/yr) **7-20-94** under the business name of **JB Environmental Drilling** by (signature) **James Bieker**

000000