


1 LOCATION OF WATER WELL: County: **Brown** Fraction: **NE 1/4 NE 1/4 SE 1/4** Section Number: **29** Township Number: **T 2 S** Range Number: **R 17 E W**

Distance and direction from nearest town or city street address of well if located within city?
310 N. 1st. Hiawatha, KS.

2 WATER WELL OWNER: **Ramona Scheid**
 RR#, St. Address, Box #: **310 N. 1st.**
 City, State, ZIP Code: **Hiawatha, KS.**
 Board of Agriculture, Division of Water Resources
 Application Number:

3 LOCATE WELL'S LOCATION WITH AN "X" IN SECTION BOX:

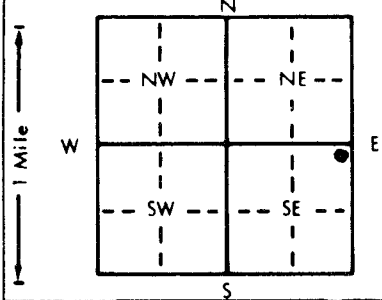

4 DEPTH OF COMPLETED WELL: **40'** ft. ELEVATION:
 Depth(s) Groundwater Encountered 1. **29'** ft. 2. ft. 3. ft.
 WELL'S STATIC WATER LEVEL: **31'2"** ft. below land surface measured on mo/day/yr **7-6-94**
 Pump test data: Well water was ft. after hours pumping gpm
 Est. Yield gpm: Well water was ft. after hours pumping gpm
 Bore Hole Diameter: **8 1/2"** in. to **40'** ft., and in. to ft.
 WELL WATER TO BE USED AS:
 5 Public water supply 8 Air conditioning 11 Injection well
 1 Domestic 3 Feedlot 6 Oil field water supply 9 Dewatering 12 Other (Specify below)
 2 Irrigation 4 Industrial 7 Lawn and garden only **10** Monitoring well
 Was a chemical/bacteriological sample submitted to Department? Yes No **X**; If yes, mo/day/yr sample was submitted
 Water Well Disinfected? Yes **No**

5 TYPE OF BLANK CASING USED:
 1 Steel 3 RMP (SR) 5 Wrought iron 8 Concrete tile CASING JOINTS: Glued Clamped
2 PVC 4 ABS 6 Asbestos-Cement 9 Other (specify below) Welded
 Blank casing diameter: **2.375** in. to **25'** ft. Dia. in. to in. to in. to SDR **13**
 Casing height above land surface: **Flush Mount** in., weight lbs./ft. Wall thickness or gauge No. **SCH 40**
 TYPE OF SCREEN OR PERFORATION MATERIAL: **7 PVC** 10 Asbestos-cement
 1 Steel 3 Stainless steel 5 Fiberglass 8 RMP (SR) 11 Other (specify)
 2 Brass 4 Galvanized steel 6 Concrete tile 9 ABS 12 None used (open hole)
 SCREEN OR PERFORATION OPENINGS ARE:
 1 Continuous slot **3 Mill slot** 5 Gauzed wrapped 8 Saw cut 11 None (open hole)
 2 Louvered shutter 4 Key punched 6 Wire wrapped 9 Drilled holes
 7 Torch cut 10 Other (specify)
 SCREEN-PERFORATED INTERVALS: From **40'** ft. to **25'** ft. From ft. to ft. to ft. to ft.
 GRAVEL PACK INTERVALS: From **40'** ft. to **23'** ft. From ft. to ft. to ft. to ft.

6 GROUT MATERIAL: 1 Neat cement 2 Cement grout 3 Bentonite 4 Other
 Grout Intervals: From **23'** ft. to **4'** ft. From **4'** ft. to **0'** ft. From ft. to ft. to ft. to ft.
 What is the nearest source of possible contamination:
 1 Septic tank 4 Lateral lines 7 Pit privy **11 Fuel storage FOUCEL** 14 Abandoned water well
 2 Sewer lines 5 Cess pool 8 Sewage lagoon 12 Fertilizer storage 16 Other (specify below)
 3 Watertight sewer lines 6 Seepage pit 9 Feedyard 13 Insecticide storage
 Direction from well: **South** How many feet? **60'**

FROM	TO	LITHOLOGIC LOG	FROM	TO	PLUGGING INTERVALS
0	.75	Asphalt/Concrete.			
.75	5.50	Med red brn silty clay till w/ gray till mottling, moist, soft, no odor.			
5.50	11.75	Gray brn silty clay till w/red brn clay till mottling, moist, no odor.			
11.75	24	Red brn silty clay till w/ gray silty clay till mottling, no odor, moist.			
24	29	Red-yellow brn silty sandy clay till, moist, no odor, fine-med grained.			
29	40	Yellow brn clayey sand, wet, fin-coarse grained, no odor.			

7 CONTRACTOR'S OR LANDOWNER'S CERTIFICATION: This water well was (1) **constructed**, (2) reconstructed, or (3) plugged under my jurisdiction and was completed on (mo/day/year) **7-6-94** and this record is true to the best of my knowledge and belief. Kansas Water Well Contractor's License No. **539** This Water Well Record was completed on (mo/day/yr) **7-20-94** under the business name **QB Environmental Drilling** by (signature) **James Burke**

000002