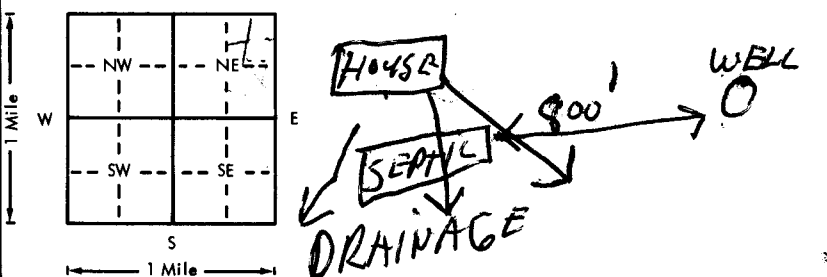


USE TYPEWRITER OR BALL
POINT PEN-PRESS FIRMLY,
PRINT CLEARLY.

WATER WELL RECORD
KSA 82a-1201-1215

40A

Kansas Department of Health and
Environment-Division of Environment
(Water well Contractors)
Topeka, Kansas 66620

1. Location of well:	County BROWN	Fraction SE 1/4 NE 1/4 NE 1/4	Section number 32	Township number T 2	Range number R 17
2. Distance and direction from nearest town or city: ONE MILE SOUTH OF HIAWATHA, KANSAS ON HIWAY 73 Street address of well location if in city:			3. Owner of well: EDGAR GAMBLE R.R. or street: RR City, state, zip code: HIAWATHA, KANSAS		
4. Locate with "X" in section below: 			6. Bore hole dia. 34 in. Completion date 10/5/75 Well depth 27 ft. FIRST 11' BORE HOLE 42"		
5. Type and color of material			7. Cable tool <input type="checkbox"/> Rotary <input type="checkbox"/> Driven <input type="checkbox"/> Dug <input type="checkbox"/> Hollow rod <input type="checkbox"/> Jetted <input checked="" type="checkbox"/> Bored <input type="checkbox"/> Reverse rotary <input type="checkbox"/>		
BLACK TOPSOIL			8. Use: <input checked="" type="checkbox"/> Domestic <input type="checkbox"/> Public supply <input type="checkbox"/> Industry <input type="checkbox"/> <input type="checkbox"/> Irrigation <input type="checkbox"/> Air conditioning <input type="checkbox"/> Stock <input type="checkbox"/> <input type="checkbox"/> Lawn <input type="checkbox"/> Oil field water <input type="checkbox"/> Other <input type="checkbox"/>		
WINDBLOWN LOESS SOIL - BROWNISH IN COLOR			9. Casing: Material CONCRETE Height: Above or below Threaded <input type="checkbox"/> Welded <input type="checkbox"/> Surface <input type="checkbox"/> 24 in. RMP <input type="checkbox"/> PVC <input type="checkbox"/> Weight 200 lbs./ft. Dia. 30 in. to 27 ft. depth Wall Thickness: inches or Dia. <input type="checkbox"/> in. to <input type="checkbox"/> ft. depth gage No. 2 in.		
BROWNISH - YELLOW SAND			10. Screen: Manufacturer's name _____ Type _____ Dia. _____ Slot/gauze _____ Length _____ Set between _____ ft. and _____ ft. _____ ft. and _____ ft. Gravel pack? _____ Size range of material _____		
EXTREMELY WET AND VERY COARSE - VERY PRODUCTIVE			11. Static water level: _____ mo./day/yr. 15 ft. below land surface Date 10/3/75		
HARD BLUE SHALE			12. Pumping level below land surfaces: 16 ft. after 2 hrs. pumping 22 g.p.m. 16 ft. after 4 hrs. pumping 22 g.p.m. Estimated maximum yield 25 g.p.m.		
			13. Water sample submitted: _____ mo./day/yr. Yes <input checked="" type="checkbox"/> No <input type="checkbox"/> Date _____		
			14. Well head completion: _____ Pitless adapter _____ Inches above grade		
			15. Well grouted? <input checked="" type="checkbox"/> With: <input checked="" type="checkbox"/> Neat cement <input type="checkbox"/> Bentonite <input type="checkbox"/> Concrete Depth: From _____ ft. to 11 ft.		
			16. Nearest source of possible contamination: ft. 800 Direction WEST Type SEPTIC Well disinfected upon completion? <input checked="" type="checkbox"/> Yes <input type="checkbox"/> No		
			17. Pump: <input checked="" type="checkbox"/> Not installed Manufacturer's name _____ Model number _____ HP _____ Volts _____ Length of drop pipe _____ ft. capacity _____ g.p.m. Type: _____ <input type="checkbox"/> Submersible <input type="checkbox"/> Turbine <input type="checkbox"/> Jet <input type="checkbox"/> Reciprocating <input type="checkbox"/> Centrifugal <input type="checkbox"/> Other		
18. Elevation: 1075 Topography: _____ <input checked="" type="checkbox"/> Hill <input checked="" type="checkbox"/> Slope <input type="checkbox"/> Upland <input type="checkbox"/> Valley			19. Remarks: CONCRETE SLAB AND VENT WILL BE INSTALLED BY CUSTOMER. HE KNOWS AND UNDERSTANDS THIS IS A REGULATION. Edgar C Gamble		
			20. Water well contractor's certification: This well was drilled under my jurisdiction and this report is true to the best of my knowledge and belief. POPPELWELL WELL BORING 320 Business name AMITY, MISSOURI License No. 64422 Address _____ Signed Jerry Poppe Date 10/29/75 Authorized Representative		

Forward the white, blue and pink copies to the Department of Health and Environment

Form WWC-5

BR = 1049 ∇ = 1060